IREDELL COUNTY HEALTH DEPARTMENT

Statesville Phone TR 3-7271 Mooresville Phone NO 3-1271

PERMIT TO INSTALL SEPTIC TANK

Permit NO. _____ Permit Date 3/26 1959

Owner Robert Hanne Address E. Broad Ext.

Installed By C. Hake & Sons Address Rte. 7 City


Location of Property Next to last house on left before 4th crick on E. Broad St. Ext.

Tank		Capacity		Length of Lines		Fixtures	
Block	( )	800	(✓)	150'	( )	No. of Baths	( )
Precast	(✓)	900	( )	175'	( )	Dishwasher	( )
		1000	( )	200'	( )	Garbage Grdr.	( )
		1100	( )	225'	(✓)	Auto-Washer	( )
		1200	( )	250'	( )	Other	
		Other		Other			

NOTIFY HEALTH DEPARTMENT AT LEAST EIGHT HOURS BEFORE TANK IS TO BE INSPECTED.

Final Inspection _____ 195__ Approved ( ) Disapproved ( )

Remarks Self app Per TEH

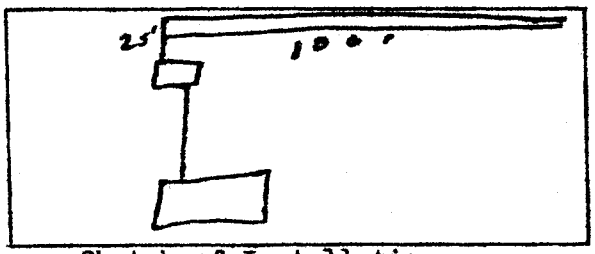

Sketch of Installation

_____

Sanitarian