IREDELL COUNTY HEALTH DEPARTMENT

Statesville Phone TR 3-7271 Mooresville Phone NO 3-1271

PERMIT TO INSTALL SEPTIC TANK

Permit NO _____ Permit Date May 20 1968

Owner Donald Webber Address Statesville N.C.

Installed By Sonny Reavis Address Harmony N.C.


Location of Property _____

Tank		Capacity		Length of Lines		Fixtures	
Block	( )	1000	(✓)	225'	(✓)	No. of Baths	( )
Precast	( )	1250	( )	250'	( )	Dishwasher	( )
		1500	( )	Other _____		Garbage Grdr.	( )
		Other _____				Other _____	

NOTIFY HEALTH DEPARTMENT AT LEAST EIGHT HOURS BEFORE TANK IS TO BE INSPECTED.

Final Inspection May 20 1968 Approved ( ) Disapproved ( )

Remarks: Tees in the clear to line

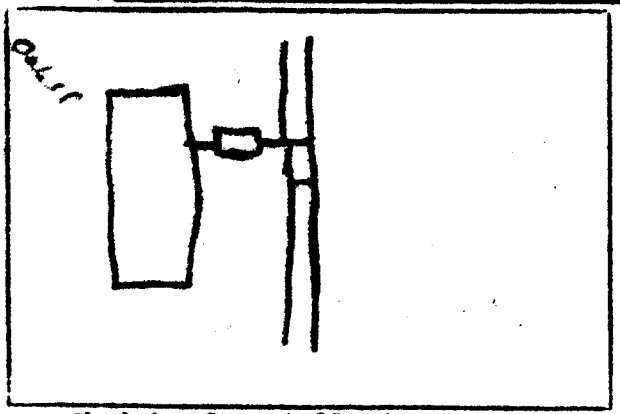

Sketch of Installation

R W [illegible]

Sanitarian