IREDELL COUNTY HEALTH DEPARTMENT

STATESVILLE 704-878-5305 MOORESVILLE 704-664-5281

IMPROVEMENT PERMIT / AUTHORIZATION TO CONSTRUCT / OPERATION PERMIT / EXISTING SYSTEM INSPECTION

PERMIT# Statesville City PIN# 4754-42-1151 DATE 8-27-98

OWNER OR CONTRACTOR Gray Crest Homes PHONE: Business 872-[illegible]2081 Home

ADDRESS 2027 Shelton Ave Statesville

LOCATION 2406 E. Greenbrier Rd - East side Drive TL Greenbrier Dr. on (R)

SUBDIVISION BLOCK / SECTION LOT LOT AREA 1.6 ac SITE CLASS. I/S DESIGN FLOW @ 360 L.T.A.R. 0.3

Septic Tank: 1000 Gallons; STB Date

Pump Tank: Gallons; PT Date

Pump Make: Model Serial No.

Nitrification Field: No Fields 1 Square Feet 420 Linear Feet 140 Ft

No Lines 2 Trench Width 36in Max Trench Bottom Depth 36in Gravel Depth 12in

[X] New System [ ] Repair System Type: I, II, III, IV, V, VI

System Description: Grunt, Conventional

Repair System Description: Grunt, Conventional

Maintenance Agreement Required: [ ] Yes [ ] No

[ ] House/Mod. Home [X] Mobile Home [ ] Business [ ] Other

No. Bedrooms 3 No. Bathrooms 2 No. Employees


[ ] Slab [X] Crawl Space [ ] Basement w/plumbing [ ] Basement w/o plumbing

Water Supply: [ ] Individual [X] Public [ ] Community


Comments:/Conditions: Install 2 lines @ 70Ft, use 2 Drop Boxes keep 10ft from property lines

Comments:/Conditions:

INITIAL SITE SKETCH

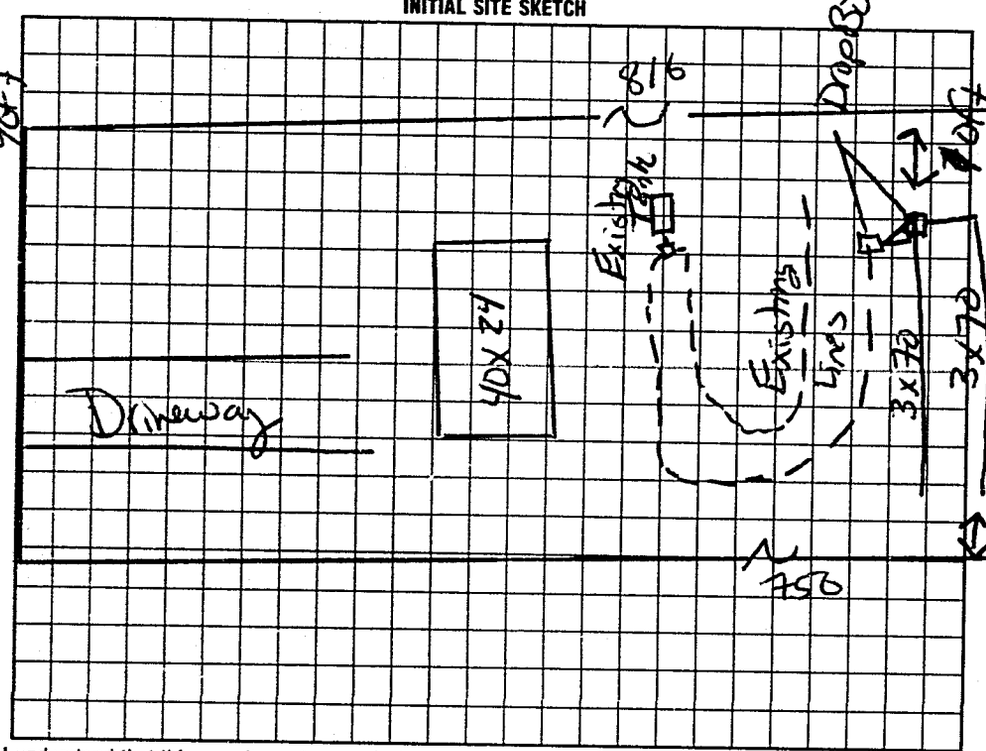

AS BUILT SKETCH

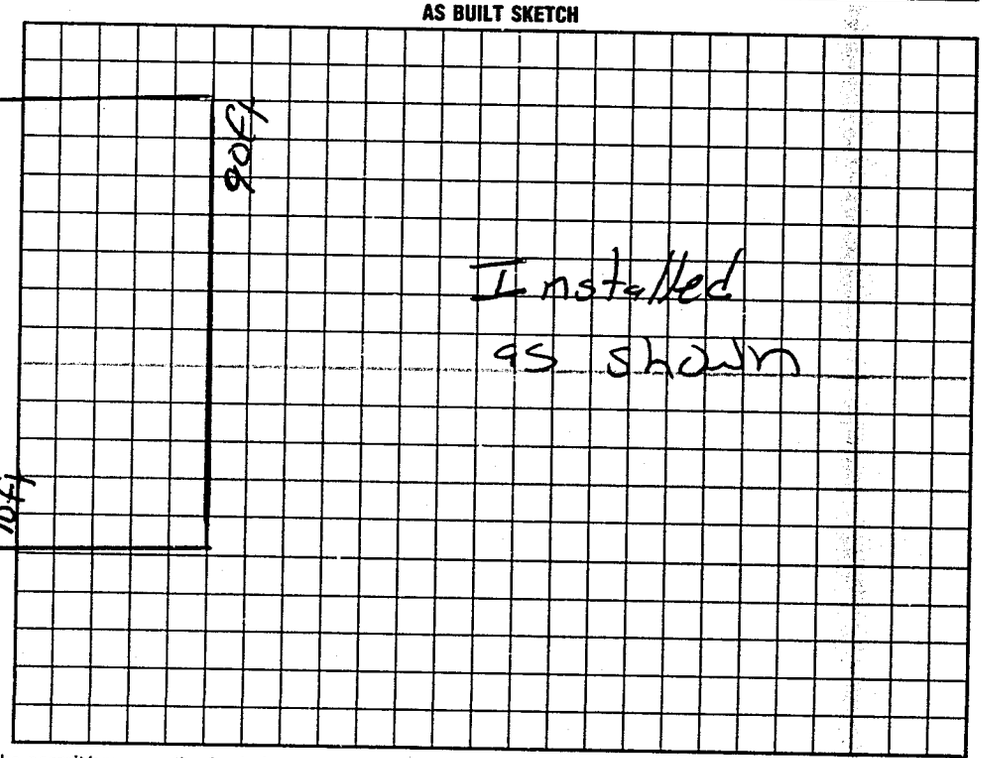

I understand that this permit can be suspended or revoked if any false information is supplied toward securing the permit/any unauthorized changes are made to the site/any unauthorized changes are made in the installation of the system. Improvement Permit with plat valid without expiration. Improvement Permit with site plan valid for sixty months. Authorization to Construct is valid for a period equal to that of Improvement Permit – not to exceed sixty months.

Signed: [X] Leon Gray date

Improvement Permit by: Mark C. Outlaw RS date 8-27-98

Authorization to Construct by: Mark C. Outlaw RS date 8-27-98

Installed by: Steve Jordan

Operation Permit by: Mark C. Outlaw RS date 9-24-98

Existing System Inspection by: date

HEALTH DEPT COPY WHITE INSPECTION COPY (FINAL) GREEN OWNER COPY (FINAL) YELLOW INSPECTION COPY (INITIAL) PINK OWNER COPY (INITIAL) GOLD