IREDELL COUNTY HEALTH DEPARTMENT

STATESVILLE 704-878-5305 MOORESVILLE 704-664-5281

IMPROVEMENT PERMIT / AUTHORIZATION TO CONSTRUCT / OPERATION PERMIT / EXISTING SYSTEM INSPECTION

PERMIT# REPAIR PIN# 4754-42-4710 DATE 3-3-09

OWNER OR CONTRACTOR ADDIE G. FEIMSTER PHONE: Business Home

ADDRESS 2424 E. GREENBRIAR ROAD STATESVILLE, NC 28625-6421

LOCATION US 64 EAST TR GREENBRIAR ROAD, HOUSE ON LEFT ACROSS FROM KING ST. AT #2424

SUBDIVISION BLOCK / SECTION LOT LOT AREA LIMITED SITE CLASS. PS DESIGN FLOW 240 L.T.A.R. EXISTING

Septic Tank: EXISTING Gallons: STB Date

Pump Tank: Gallons: PT Date

Pump Make: Model Serial No.

Nitrification Field: No Fields 1 Square Feet Linear Feet EXISTING

No Lines BED Trench Width Max Trench Bottom Depth

☐ New System ☑ Repair System Type: I (II) III, IV, V, VI

System Description: CONVENTIONAL, GRAVITY

Repair System Description: CONV. GRAVITY

Maintenance Agreement Required: ☐ Yes ☑ No

Gravel Depth EXISTING ☐ Slab ☑ Crawl Space ☐ Basement w/plumbing ☐ Basement wo/plumbing

☑ House/Mod. Home No. Bedrooms 2

☐ Mobile Home No. Bathrooms 1

☐ Business No. Employees

☐ Other


Water Supply: ☑ Individual ☐ Public ☐ Community

WELL

Comments:/Conditions: REPLACE SANITARY TEE IN SEPTIC TANK AND SUPPLY LINE WHERE ROOTS HAVE CLOGGED EXISTING LINE.

Comments:/Conditions:

INITIAL SITE SKETCH

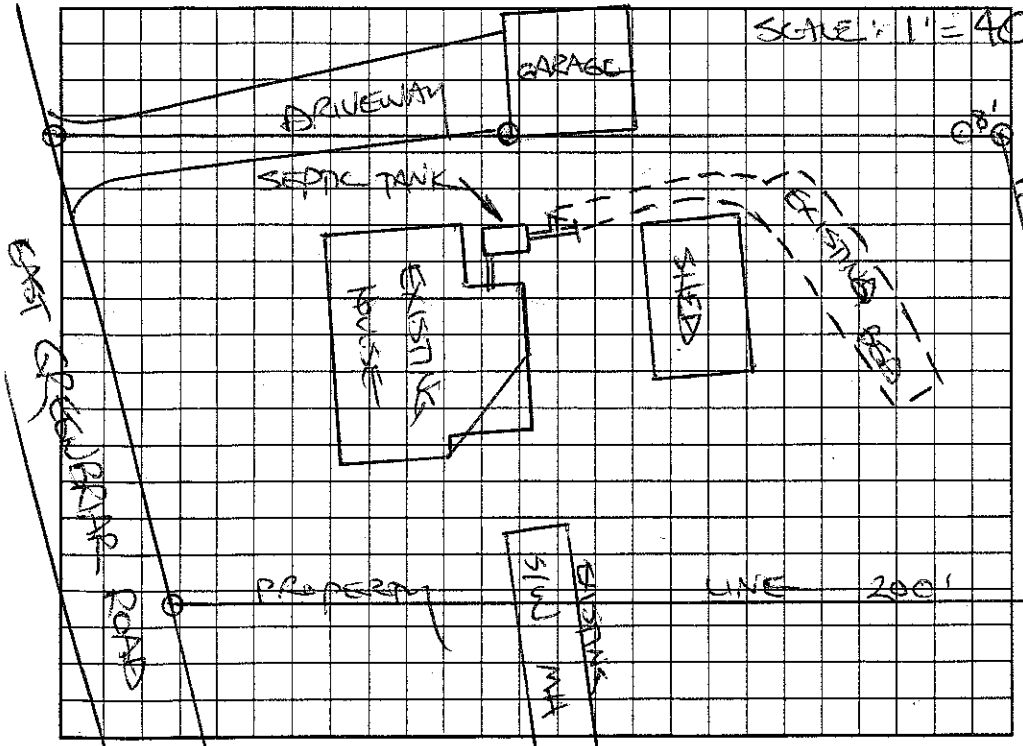

AS BUILT SKETCH

SYSTEM REPAIRED ACCORDING TO INITAL SITE SKETCH

Permit can be suspended or revoked if any false information is supplied toward securing the permit/any unauthorized changes are made to the site/any unauthorized changes are made in the installation of the system. Improvement Permit with plat valid without expiration. Improvement Permit with site plan valid for sixty months. Authorization to Construct is valid for a period equal to that of Improvement Permit – not to exceed sixty months.

Signed: Mrs Addie G. Feimster date 3-3-09 Installed by: WES LYTTON

Improvement Permit by: STEVE HENDRICK date 3-3-09 Operation Permit by: STEVE HENDRICK date 3-3-09

Authorization to Construct by: STEVE HENDRICK date 3-3-09 Existing System Inspection by: date

HEALTH DEPT. COPY: WHITE OWNER COPY (FINAL): YELLOW OWNER COPY (INITIAL): PINK