IREDELL COUNTY HEALTH DEPARTMENT

STATESVILLE 704-878-5305 (C1) MOORESVILLE 704-664-5281

IMPROVEMENT PERMIT / AUTHORIZATION TO CONSTRUCT / OPERATION PERMIT / EXISTING SYSTEM INSPECTION

(C1)

PERMIT# 134314 PIN# 4754-43-0153 DATE 3-24-06

OWNER OR CONTRACTOR JANET ANN NICHOLS PHONE: Business 704-770-8828 Home 704-872-2252

ADDRESS 126 CORRY DR, STATESVILLE, NC 28625

LOCATION EAST GREENBRIAR RD, TO FREEDOM DRIVE, 3RD LOT ON RIGHT AT BOX # 1141

SUBDIVISION GO FORTH BLOCK / SECTION LOT 9 LOT AREA 0.4 ACRE SITE CLASS PS DESIGN FLOW 360 L.T.A.R. 0.30 GPD/FT²

Septic Tank: 1000 Gallons; STB 760 Date 6-16-06
Pump Tank: Gallons; PT Date
Pump Make: Model Serial No.
Nitrification Field: No Fields 1 Square Feet EQ TO 1200 Linear Feet 200
No Lines FOUR Trench Width 24" Max Trench Bottom Depth 36" Gravel Depth SAND 24"

☑ New System ☐ Repair System Type: I, II, III, IV, V, VI
System Description: 50% REDUCTION, GRAVITY
Repair System Description: 30% REDUCTION, LOW-PRESSURE
Maintenance Agreement Required: ☐ Yes ☑ No

☐ House/Mod. Home ☑ Mobile Home ☐ Business ☐ Other
No. Bedrooms 3 No. Bathrooms No. Employees


Water Supply: ☐ Individual ☑ Public ☑ Community

☐ Slab ☑ Crawl Space ☐ Basement w/plumbing ☐ Basement wo/plumbing

Comments:/Conditions: (1) REMOVE EXISTING S/W MH, ABANDON EXISTING SEPTIC TANK (2) INSTALL 50% REDUCTION SYSTEM USING 48 PPBDS PANELS ON CONTOUR (3) USE ONE EFFLUENT SPLITTER TO ACHIEVE EQUAL DISTRIBUTION

Comments:/Conditions: SEPTIC TANK WITH MARKER INSTALLED USING "RED BOYLOK" FILTER

INITIAL SITE SKETCH

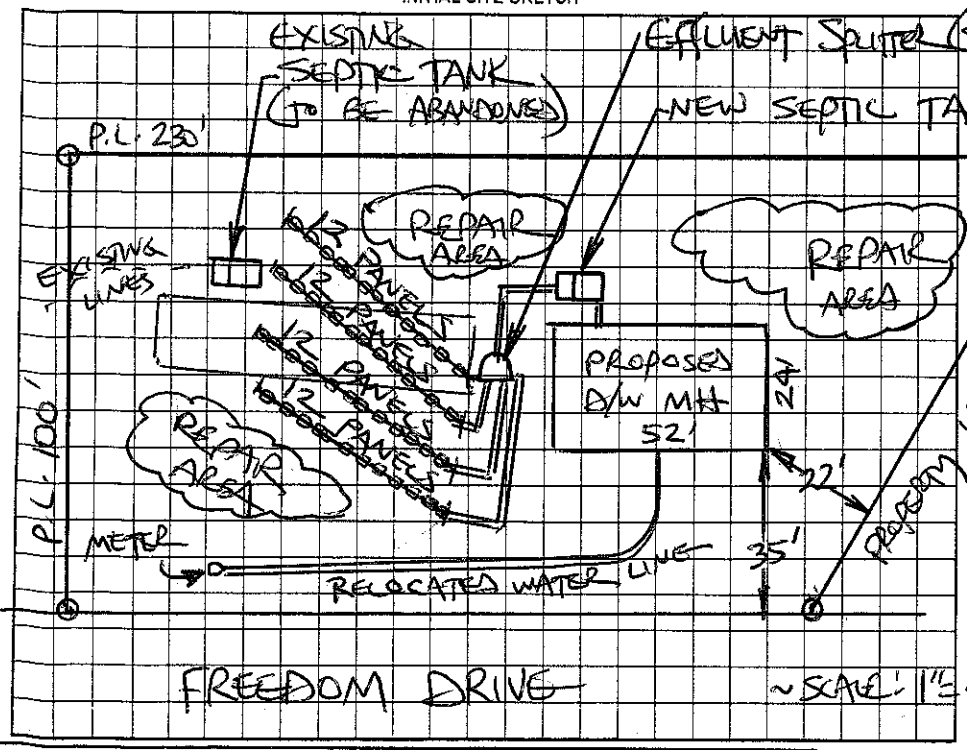

AS BUILT SKETCH

SYSTEM INSTALLED ACCORDING TO INITIAL SITE SKETCH

Permit can be suspended or revoked if any false information is supplied toward securing the permit/any unauthorized changes are made to the site/any unauthorized changes are made in the installation of the system. Improvement Permit with plat valid without expiration. Improvement Permit with site plan valid for sixty months. Authorization to Construct is valid for a period equal to that of Improvement Permit – not to exceed sixty months.

Signed: [signature] date 3-27-06 Installed by: TIM ABEE GRADING

Improvement Permit by: STEVE HEDRICK date 3-24-06 Operation Permit by: STEVE HEDRICK date 6-6-06

Authorization to Construct by: STEVE HEDRICK date 3-24-06 Existing System Inspection by: date

HEALTH DEPT. COPY: WHITE OWNER COPY (FINAL): YELLOW OWNER COPY (INITIAL): PINK