IREDELL COUNTY HEALTH DEPARTMENT

Statesville Phone TR 3-7271 Mooresville Phone NO 3-1271

PERMIT TO INSTALL SEPTIC TANK

Permit NO. _____ Permit Date Feb 10 19 70

Owner Hoyt Bry. Address Statesville NC.

Installed By Adams Address Taylorsville N.C.


Location of Property King St Lot # 25

Tank		Capacity		Length of Lines		Fixtures	
Block	( )	1000	(✓)	225'	( )	No. of Baths	( )
Precast	(✓)	1250	( )	250'	( )	Dishwasher	( )
		1500	( )	Other 300 ft 4 inch tile		Garbage Grdr.	( )
		Other _____				Other _____	

NOTIFY HEALTH DEPARTMENT AT LEAST EIGHT HOURS BEFORE TANK IS TO BE INSPECTED.

Final Inspection Feb 13 19 70 Approved (✓) Disapproved ( )

Remarks _____

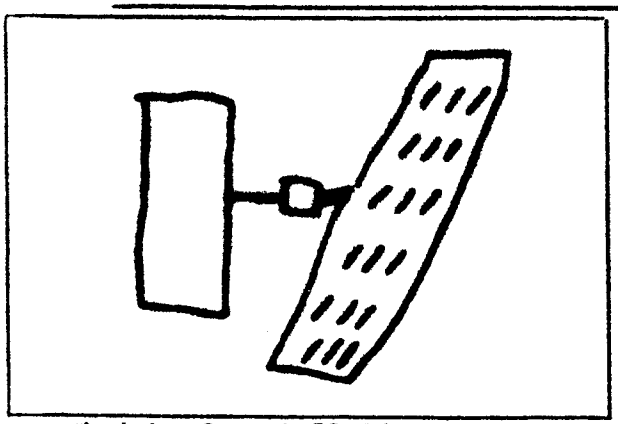

Sketch of Installation

Robbie W Johnson RS

Sanitarian