IREDELL COUNTY HEALTH DEPARTMENT

Statesville Phone TR 3-7271 Mooresville Phone NO 3-1271

PERMIT TO INSTALL SEPTIC TANK

Permit NO. 0 Permit Dat Feb 6 1970

Owner Hope Fro Address Statesville N.C.,

Installed By Adams Address


Location of Property King St Lot #24

Tank		Capacity		Length of Lines		Fixtures	
Block	( )	1000	(✓)	225'	( )	No. of Baths	( )
Precast	(✓)	1250	( )	250'	( )	Dishwasher	( )
		1500	( )	Other 300 Lin ft 900 sq ft		Garbage Grdr.	( )
		Other				Other	

NOTIFY HEALTH DEPARTMENT AT LEAST EIGHT HOURS BEFORE TANK IS TO BE INSPECTED.

Final Inspection Feb 6 1970 Approved (✓) Disapproved ( )

Remarks

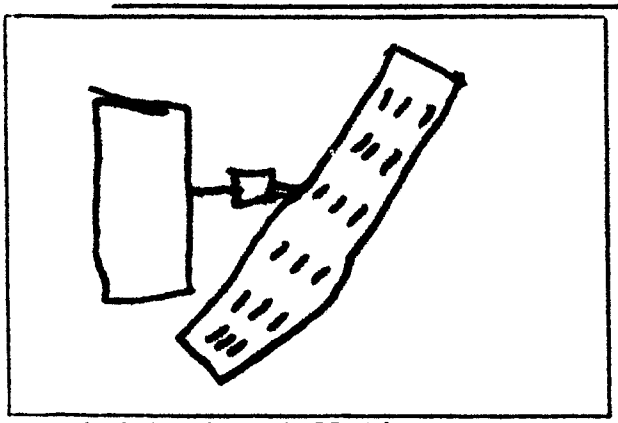

Sketch of Installation

Sanitarian