IREDELL COUNTY HEALTH DEPARTMENT

Statesville Phone TR 3-7271 Mooresville Phone NO 3-1271

PERMIT TO INSTALL SEPTIC TANK

Permit No. 123 Permit Date [illegible] 19[illegible]

Owner [illegible] Address [illegible]

Installed By [illegible] Address [illegible]

Location of Property [illegible]

[illegible]


Lot # 31

Tank		Capacity		Length of Lines		Fixtures	
Block	( )	1000	(✓)	225'	(✓)	No. of Baths	( )
Precast	(✓)	1250	( )	250'	( )	Dishwasher	( )
		1500	( )	Other		Garbage Grdr.	( )
		Other				Other	

NOTIFY HEALTH DEPARTMENT AT LEAST EIGHT HOURS BEFORE TANK IS TO BE INSPECTED.

Final Inspection [illegible] 19[illegible] Approved (✓) Disapproved ( )

Remarks Community Water

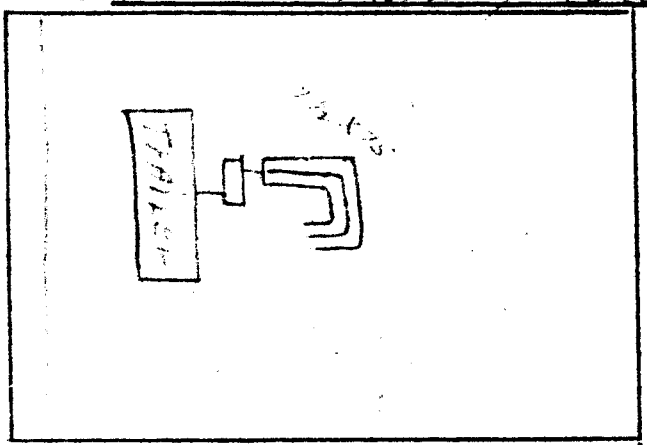

Sketch of Installation

[illegible]

Sanitarian