IREDELL COUNTY HEALTH DEPARTMENT

STATESVILLE 704-878-5305 MOORESVILLE 704-664-5281

IMPROVEMENT PERMIT / AUTHORIZATION TO CONSTRUCT / OPERATION PERMIT / EXISTING SYSTEM INSPECTION

PERMIT# REPAIR PIN# 4754-43-1459 DATE 8-25-2008

OWNER OR CONTRACTOR MAE D. RAMSEUR PHONE: Business Home

ADDRESS 1130 KING STREET STATESVILLE, NC 28625-6417

LOCATION GREEN BRIAR ROAD TO KING STREET, HOUSE #1130 ON LEFT

SUBDIVISION HOPE BROTHERS BLOCK / SECTION LOT 29 LOT AREA .61 ACRE SITE CLASS. PS DESIGN FLOW 360 L.T.A.R. EXISTING

Septic Tank: 1000 Gallons; STB 1012 Date 3-24-08
Pump Tank: Gallons; PT Date
Pump Make: Model Serial No.
Nitrification Field: No Fields 1 Square Feet EX Linear Feet EX
No Lines EX Trench Width EX Max Trench Bottom Depth EX Gravel Depth EX

☐ New System ☑ Repair System Type: I, II, III, IV, V, VI
System Description:
Repair System Description: CONVENTIONAL, GRAVITY
Maintenance Agreement Required: ☐ Yes ☑ No

☑ House/Mod. Home No. Bedrooms 3
☐ Mobile Home No. Bathrooms
☐ Business No. Employees
☐ Other


☐ Slab ☑ Crawl Space ☐ Basement w/plumbing ☐ Basement wo/plumbing

Water Supply: ☐ Individual ☑ Public ☑ Community


Comments/Conditions: REPLACE COLLAPSED SEPTIC TANK AT LOCATION SHOWN. THIS PERMIT SERVES AS "NOTICE of VIOLATION" TO BE REPAIRED BY SEPTEMBER 25, 2008

Comments/Conditions:

INITIAL SITE SKETCH

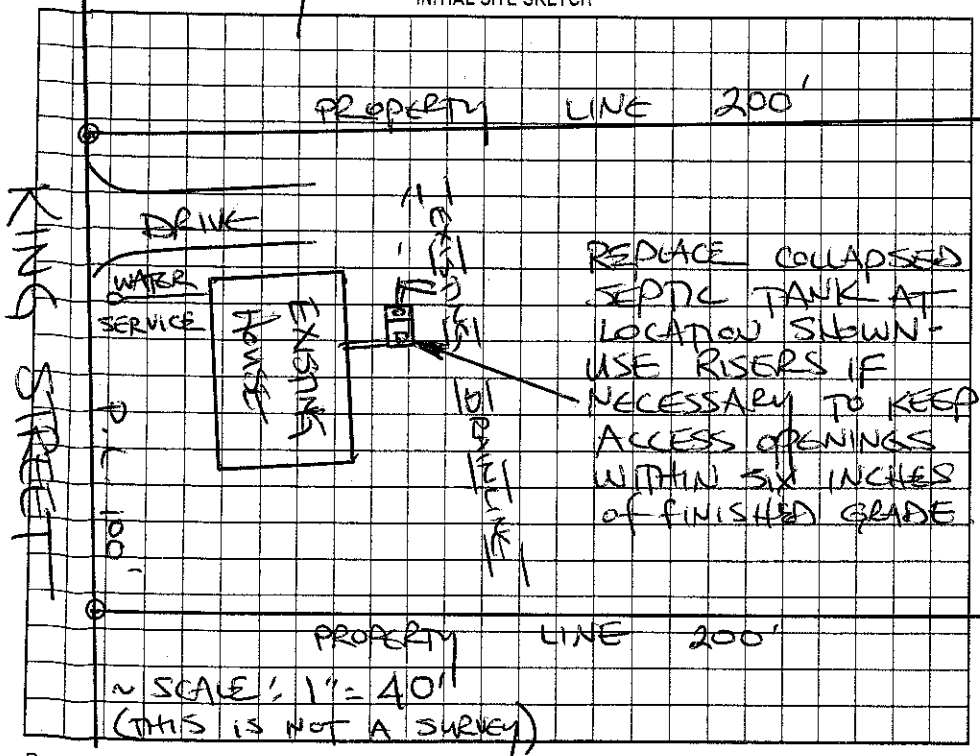

AS BUILT SKETCH

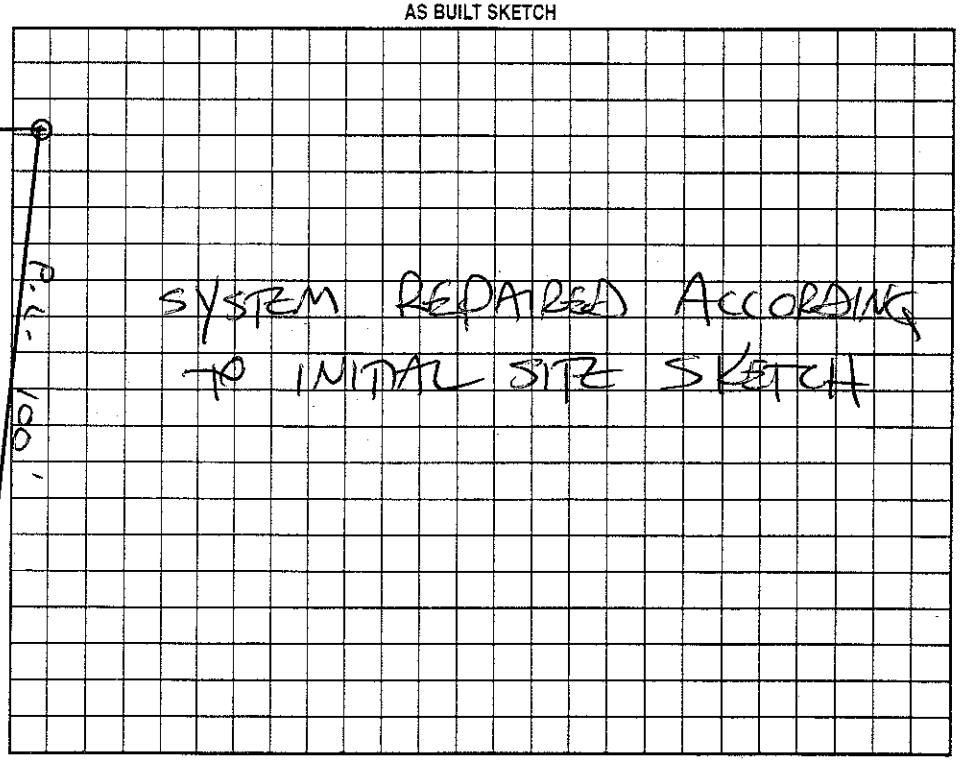

Permit can be suspended or revoked if any false information is supplied toward securing the permit/any unauthorized changes are made to the site/any unauthorized changes are made in the installation of the system. Improvement Permit with plat valid without expiration. Improvement Permit with site plan valid for sixty months. Authorization to Construct is valid for a period equal to that of Improvement Permit – not to exceed sixty months.

Signed: x Mae D. Ramseur date 8-25-2008 Installed by: JARED LENTZ

Improvement Permit by: STEVE HEDRICK date 8-25-2008 Operation Permit by: STEVE HEDRICK date 9-3-08

Authorization to Construct by: STEVE HEDRICK date 8-25-2008 Existing System Inspection by: date

HEALTH DEPT. COPY: WHITE OWNER COPY (FINAL): YELLOW OWNER COPY (INITIAL): PINK