IREDELL COUNTY HEALTH DEPARTMENT

Statesville Phone TR 3-7271 Mooresville Phone NO 3-1271

PERMIT TO INSTALL SEPTIC TANK

Permit No. _____ Permit Date Dec 1 1969

Owner Hope Bro Address King St Statesville NC

Installed By Hope Bro. Address Statesville NC.

Location of Property Off Murdock Rd.

Def # 28


Perk Test 60 min.

Tank		Capacity		Length of Lines		Fixtures	
Block	( )	1000	(✓)	225'	( )	No. of Baths	( )
Precast	(✓)	1250	( )	250'	( )	Dishwasher	( )
		1500	( )	Other 200' & 75'		Garbage Grdr.	( )
		Other				Other	

NOTIFY HEALTH DEPARTMENT AT LEAST EIGHT HOURS BEFORE TANK IS TO BE INSPECTED.

Final Inspection Dec 1 1969 Approved (✓) Disapproved ( )

Remarks _____

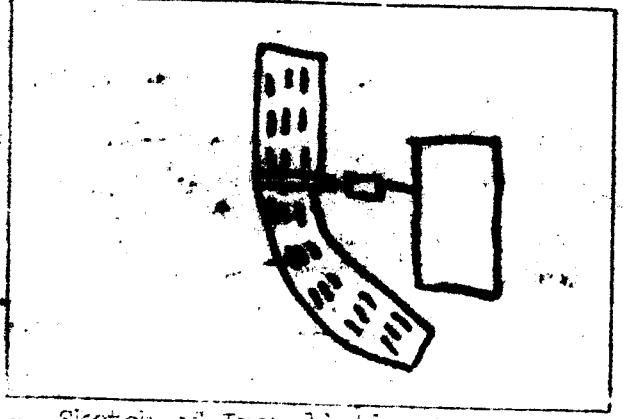

Sketch of Installation

Collie W Johnson Jr.

Sanitarian