IREDELL COUNTY HEALTH DEPARTMENT

Statesville Phone TR 3-7271 Mooresville Phone NO 3-1271

PERMIT TO INSTALL SEPTIC TANK

Permit NO. 27 Permit Date Feb 13 1970

Owner Hope Lee Address Statesville N.C.

Installed By Adams Address Taylorsville N.C.


Location of Property King St Lot # 26

Tank		Capacity		Length of Lines		Fixtures	
Block	( )	1000	(✓)	225'	( )	No. of Baths	( )
Precast	(✓)	1250	( )	250'	( )	Dishwasher	( )
		1500	( )	Other 300 ft Lines 9.0 ea ft		Garbage Grdr.	( )
		Other				Other	

NOTIFY HEALTH DEPARTMENT AT LEAST EIGHT HOURS BEFORE TANK IS TO BE INSPECTED.

Final Inspection Feb 13 1970 Approved (✓) Disapproved ( )

Remarks

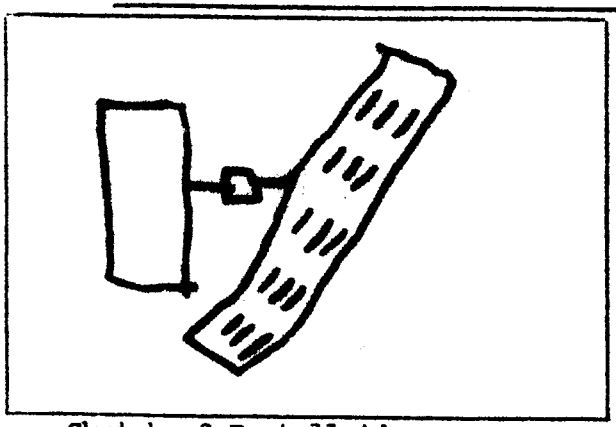

Sketch of Installation

Sanitarian