1702

IREDELL COUNTY HEALTH DEPARTMENT

Statesville Phone TR 3-7271 Mooresville Phone NO 3-1271

PERMIT TO INSTALL SEPTIC TANK

Permit No. Hope Rose Estates Permit Date May 20 1969

Owner Iredell Rentals Inc. Address R)

Installed By C Hoke & Son Address R7


Location of Property Murdock Rd. #7 Lester R.

Tank		Capacity		Length of Lines		Fixtures	
Block	( )	1000	( )	225'	( )	No. of Baths	(1)
Precast	(✓)	1250	( )	250'	( )	Dishwasher	( )
		1500	( )	Other		Garbage Grdr.	( )
cast		Other				Other	

NOTIFY HEALTH DEPARTMENT AT LEAST EIGHT HOURS BEFORE TANK IS TO BE INSPECTED.

Final Inspection 19 Approved (✓) Disapproved ( )

Remarks central water supply. not liable any harm from grade a landscape changes

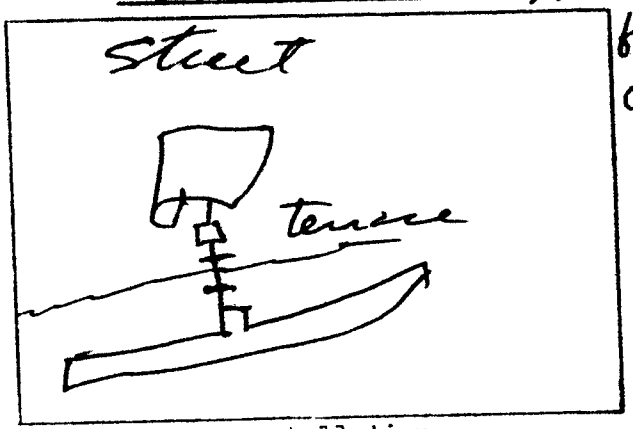

Sketch of Installation

Sanitarian