IREDELL COUNTY HEALTH DEPARTMENT

Statesville Phone TR 3-7271 Mooresville Phone NO 3-1271

PERMIT TO INSTALL SEPTIC TANK

Permit No. _____ Permit Date Dec 1, 1969

Owner Wayne Rev. Address Route 5 Statesville N.C.

Installed By Hobert Rev Address Statesville N.C.

Location of Property off Murdock Rd


Perk Test 10 min

Tank		Capacity		Length of Lines		Fixtures	
Block	( )	1000	✓	225'	( )	No. of Baths	( )
Precast	(✓)	1250	( )	250'	( )	Dishwasher	( )
		1500	( )	Other 200' 24" w/ 4" tile		Garbage Grdr.	( )
		Other				Other	

NOTIFY HEALTH DEPARTMENT AT LEAST EIGHT HOURS BEFORE TANK IS TO BE INSPECTED.

Final Inspection Dec 1, 1969 Approved (✓) Disapproved ( )

Remarks _____

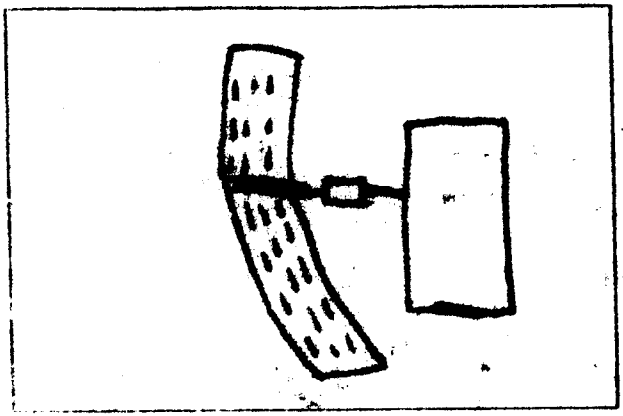

Sketch of Installation

Kellie W Johnson R.S.

Sanitarian