IREDELL COUNTY HEALTH DEPARTMENT

Statesville Phone TR 3-7271 — Mooresville Phone NO 3-1271

PERMIT TO INSTALL SEPTIC TANK

Permit NO. # 145 — Permit Date April 9 19 69

Owner Hope Bros Bldrs. Inc. — Address R7 city

Installed By C. Hoke & Sons — Address R7 city


Location of Property Murdock Rd Project. #1 on Right.

Tank		Capacity		Length of Lines		Fixtures	
Block	( )	1000	( )	225'	( )	No. of Baths	( )
Precast	( )	1250	( )	250'	( )	Dishwasher	( )
Mesh		1500	( )	Other		Garbage Grdr.	( )
		Other				Other	

NOTIFY HEALTH DEPARTMENT AT LEAST EIGHT HOURS BEFORE TANK IS TO BE INSPECTED.

Final Inspection ____ 19__ — Approved ( ) Disapproved ( )

Remarks Central water supply - not this prop. Not liable any grading or landscape damage.

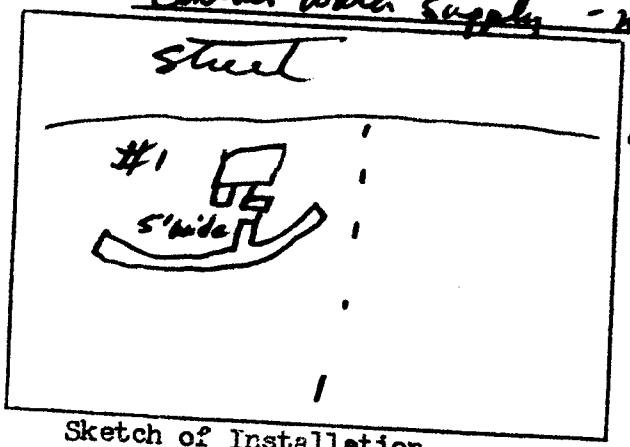

Sketch of Installation

Sanitarian