Not on Book

IREDELL COUNTY HEALTH DEPARTMENT

Statesville Phone TR 3-7271 Mooresville Phone NO 3-1271

PERMIT TO INSTALL SEPTIC TANK

Permit No. _____ Permit Date Sept 29 1971

Owner Hope Rev Pinckney Address King St

Installed By Sam Address King St #2

Location of Property Repairs to Septic tank line


Lot # 2 King St

Tank		Capacity		Length of Lines		Fixtures	
Block	( )	1000	( )	225'	( )	No. of Baths	( )
Precast	( )	1250	( )	250'	( )	Dishwasher	( )
		1500	( )	Other 150 ft		Garbage Grdr.	( )
		Other _____				Other _____	

NOTIFY HEALTH DEPARTMENT AT LEAST EIGHT HOURS BEFORE TANK IS TO BE INSPECTED.

Final Inspection Sept 29 1971 Approved (✓) Disapproved ( )

Remarks _____

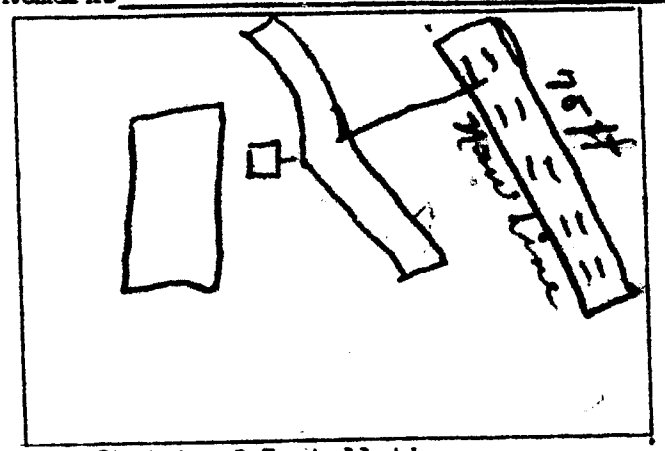

Sketch of Installation

Nellie W Johnson RS

Sanitarian