IREDELL COUNTY HEALTH DEPARTMENT

Statesville Phone TR 3-7271 Mooresville Phone NO 3-1271

PERMIT TO INSTALL SEPTIC TANK

Permit NO. Iredell Rental Dev. Permit Date April 9 1969

Owner Hope Bros. Blders. Inc. Address R 7 city

Installed By C Hoke Eson Address R 7 city


Location of Property Murdock Rd #2 - Iredell Rentals

Tank		Capacity		Length of Lines		Fixtures	
Block	( )	1000	( )	225'	( )	No. of Baths	(1)
Precast	(✓)	1250	( )	250'	( )	Dishwasher	( )
wash		1500	( )	Other		Garbage Grdr.	( )
		Other				Other	

NOTIFY HEALTH DEPARTMENT AT LEAST EIGHT HOURS BEFORE TANK IS TO BE INSPECTED.

Final Inspection 19 Approved ( ) Disapproved ( )

Remarks Central water supply. Not liable any grading damages or grade change.

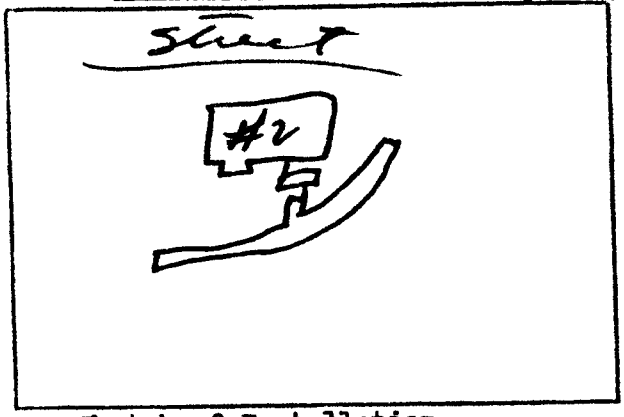

Sketch of Installation

Sanitarian