IREDELL COUNTY HEALTH DEPARTMENT

STATESVILLE 704-878-5305 MOORESVILLE 704-664-5281

IMPROVEMENT PERMIT / AUTHORIZATION TO CONSTRUCT / OPERATION PERMIT / EXISTING SYSTEM INSPECTION

PERMIT# _____ PIN# _____ DATE 11-2-98

OWNER OR CONTRACTOR Mary Tucker PHONE: Business _____ Home 981-0104

ADDRESS 1145 King St.

LOCATION E Greenbrair & Turn King St 2nd Home Rt

SUBDIVISION _____ BLOCK / SECTION _____ LOT _____ LOT AREA 1/2 acre SITE CLASS IV DESIGN FLOW 360 L.T.A.R .125

Septic Tank: Ex. Gallons: STB _____ Date _____

Pump: Maytag washer Gallons: PT Box 75 gal. Date _____

Pump Make: _____ Model _____ Serial No _____

Nitrification Field: No Fields 2 Square Feet 540 Linear Feet 180

No Lines 2 Trench Width 72" Max Trench Bottom Depth 36" Gravel Depth 18"

New System ☑ Repair System Type: I II III IV V VI

System Description: _____

Repair System Description: Conv. Gravity

Maintenance Agreement Required: Yes No ☑

☑ House/Mod. Home No. Bedrooms 3

Mobile Home No. Bathrooms 3

Business No. Employees _____

Other _____


Slab ☑ Crawl Space Basement w/plumbing Basement wo/plumbing

Water Supply: ☐ Individual ☑ Public ☐ Community

Comments:/Conditions:

Comments:/Conditions: Checked house system 5/7

INITIAL SITE SKETCH

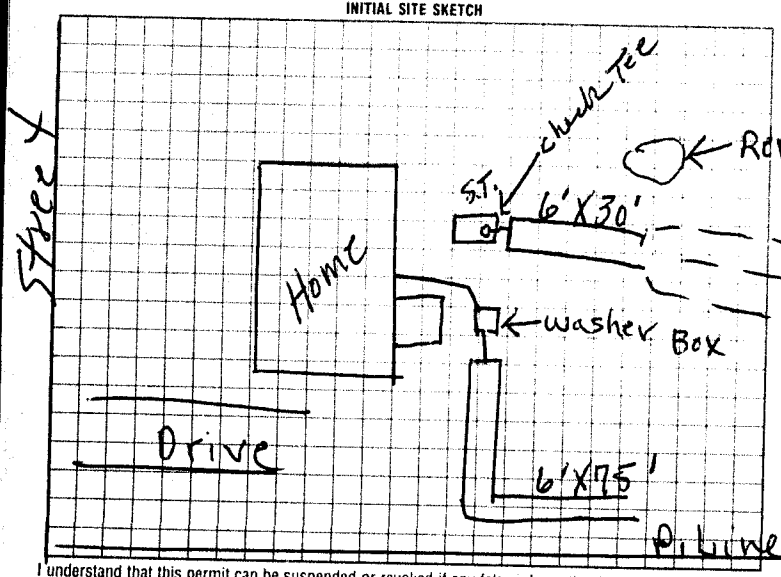

AS BUILT SKETCH

I understand that this permit can be suspended or revoked if any false information is supplied toward securing the permit/any unauthorized changes are made to the site/any unauthorized changes are made in the installation of the system. Improvement Permit with plat valid without expiration. Improvement Permit with site plan valid for sixty months. Authorization to Construct is valid for a period equal to that of Improvement Permit – not to exceed sixty months.

Signed: X Mary Tucker date _____ Installed by: Matney's Backhoe

Improvement Permit by: P. C. Moore date 11-2-98 Operation Permit by: 9M4 Cat RS date 5-13-99

Authorization to Construct by: P. C. Moore date 11-2-98 Existing System Inspection by: _____ date _____

HEALTH DEPT. COPY: WHITE INSPECTION COPY (FINAL): GREEN OWNER COPY (FINAL): YELLOW INSPECTION COPY (INITIAL): PINK OWNER COPY (INITIAL): GOLD