IREDELL COUNTY HEALTH DEPARTMENT

Statesville Phone TR 3-7271 Mooresville Phone NO 3-1271

PERMIT TO INSTALL SEPTIC TANK

Permit NO. Hoke Bros Elders. Permit Date May 30 1969

Owner Iredell Rentals Inc. Address RT Sta.

Installed By C Hoke & Sons Address R7


Location of Property Murdock Dl jobsite #6 on R. Kings St.

Tank		Capacity		Length of Lines		Fixtures	
Block	( )	1000	( )	225'	( )	No. of Baths	( )
Precast	(L)	1250	( )	250'	( )	Dishwasher	( )
Wash.		1500	( )	Other		Garbage Grdr.	( )
		Other				Other	

NOTIFY HEALTH DEPARTMENT AT LEAST EIGHT HOURS BEFORE TANK IS TO BE INSPECTED.

Final Inspection 19 Approved (✓) Disapproved ( )

Remarks Central Water supply - not liable any damage from grade or landscape work.

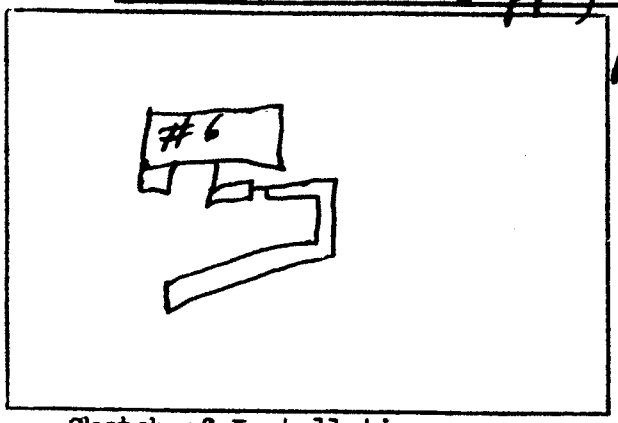

Sketch of Installation

Sanitarian