IREDELL COUNTY HEALTH DEPARTMENT

Statesville Phone TR 3-7271 — Mooresville Phone NO 3-1271

PERMIT TO INSTALL SEPTIC TANK

Permit No. 101 — Permit Date 2/14 19 22

Owner Hope Bro. Builders — Address Route 7, City

Installed By Hope Bro. Builders — Address Route 7, City


Location of Property King Street Lot No. 57

Tank		Capacity		Length of Lines		Fixtures	
Block	( )	1000	(✓)	225'	( )	No. of Baths	(1)
Precast	(✓)	1250	( )	250'	( )	Dishwasher	( )
		1500	( )	Other 900 sq ft		Garbage Grdr.	( )
		Other				Other	

NOTIFY HEALTH DEPARTMENT AT LEAST EIGHT HOURS BEFORE TANK IS TO BE INSPECTED.

Final Inspection _____ 19___ — Approved (✓) Disapproved ( )

Remarks _____

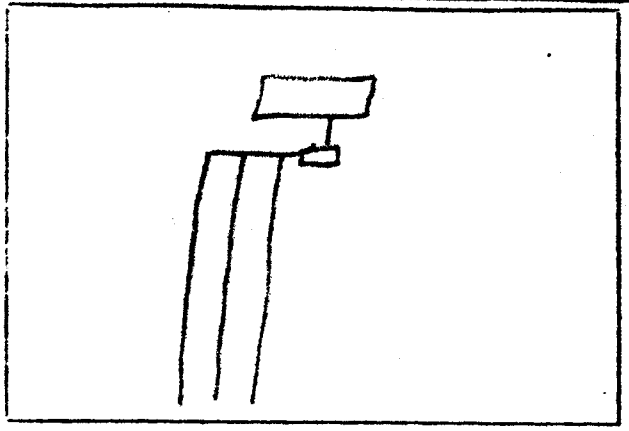

Sketch of Installation

Not Checked

Sanitarian