IREDELL COUNTY HEALTH DEPARTMENT

Statesville Phone TR 3-7271 Mooresville Phone NO 3-1271

PERMIT TO INSTALL SEPTIC TANK

Permit No. 207 Permit Date _____ 19__

Owner Hope Brothers Address Statesville, N.C.

Installed By Floyd Adams Address Taylorsville N.C.


Location of Property Murdock Rd. to King St. Go to end of street, turn left. 1st house on left.

Tank		Capacity		Length of Lines		Fixtures	
Block	( )	1000	( )	225'	( )	No. of Baths	(2)
Precast	(✓)	1250	( )	250'	( )	Dishwasher	( )
		1500	( )	Other _____		Garbage Grdr.	( )
		Other _____				Other _____	

NOTIFY HEALTH DEPARTMENT AT LEAST EIGHT HOURS BEFORE TANK IS TO BE ~~INSPECTED~~.

Final Inspection 7-25-1921 Approved (✓) Disapproved ( )

Remarks _____

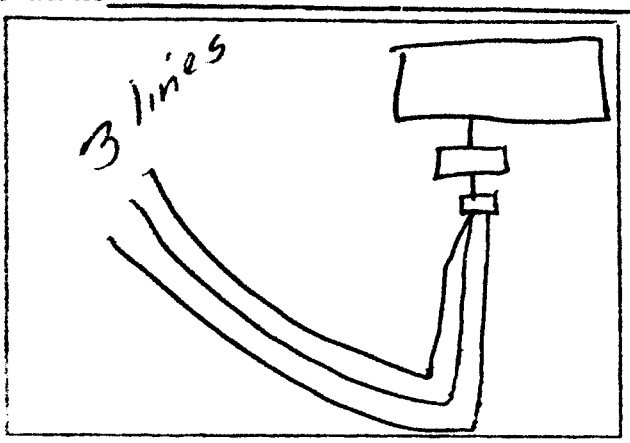

Sketch of Installation

Cleon S. Hare

Sanitarian