IREDELL COUNTY HEALTH DEPARTMENT

Statesville Phone TR 3-7271 Mooresville Phone NO 3-1271

PERMIT TO INSTALL SEPTIC TANK

Permit No. 119 Permit Date 1-14 19 71

Owner Hope Bro. Builders INC Address Statesville, NC

Installed By Adams Septic Tank Service Address Taylorsville, NC.


Location of Property (Belmont) Murdock Rd. Turn left on King St. Lot # 56

Tank		Capacity		Length of Lines		Fixtures	
Block	( )	1000	(✓)	225'	(✓)	No. of Baths	(1)
Precast	(✓)	1250	( )	250'	( )	Dishwasher	( )
		1500	( )	Other		Garbage Grdr.	( )
		Other				Other	

NOTIFY HEALTH DEPARTMENT AT LEAST EIGHT HOURS BEFORE TANK IS TO BE INSPECTED.

Final Inspection 1-14 19 71 Approved (✓) Disapproved ( )

Remarks Community Well

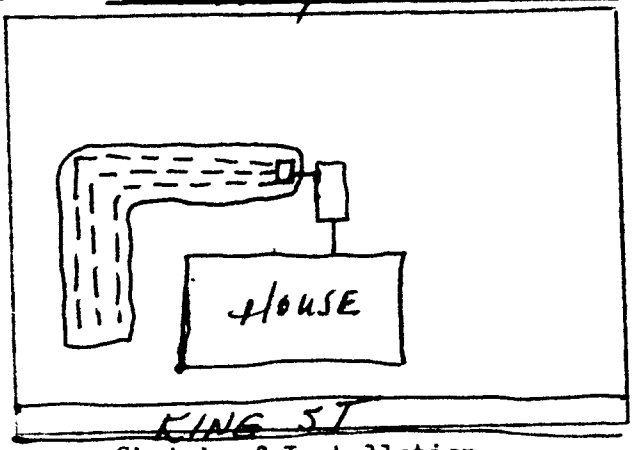

Sketch of Installation

Glenn Fox

Sanitarian