IREDELL COUNTY HEALTH DEPARTMENT

Statesville Phone TR 3-7271 Mooresville Phone No. 664-5281

PERMIT TO INSTALL SEPTIC TANK

Permit No. _____ Permit Date 6-8 1973

Owner Hope Bros Bldrs Address Statesville, NC

Installed By Hope Bros Address Statesville, NC


Location of Property Murdock Rd. LEFT ON KING ST. LOT # 68

Tank		Capacity		Length of Lines		Fixtures	
Block	( )	1000	( )	225'	( )	No. of Baths	(1½)
Precast	(✓)	1250	( )	250'	( )	Dishwasher	( )
		1500	( )	Other 300 90 LG FT		Garbage Grdr.	( )
		Other _____				Other _____	

NOTIFY HEALTH DEPARTMENT AT LEAST EIGHT HOURS BEFORE TANK IS TO BE INSPECTED.

Final Inspection 6-8 1973 Approved (✓) Disapproved ( )

Remarks Community Water Supply

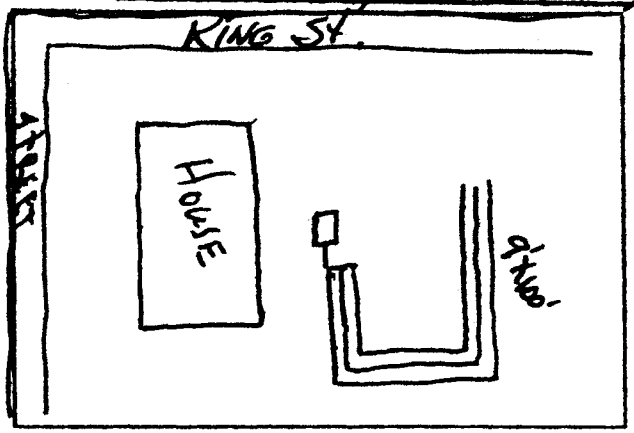

Sketch of Installation

Glenn Taylor

Sanitarian