IREDELL COUNTY HEALTH DEPARTMENT

IMPROVEMENT PERMIT AND CERTIFICATE OF COMPLETION / OPERATIONS PERMIT

OWNER OR CONTRACTOR DEQUILLA WHITE DATE 4-24-92. PERMIT NO. _____

PHONE: Business _____ Home _____

LOCATION 1105 King street off Greenbriar Rd.

_____ S.R. No. _____

SUBDIVISION NAME _____ LOT NO. _____ SECTION OR BLOCK NO. _____

House [✓] Mobile Home [ ] Business [ ] Other Repair.

No. Bedrooms _____ No. Bathrooms _____

Garbage Disposal Unit Yes [ ] No [ ]

Auto. Dishwasher Yes [ ] No [ ]

Auto. Wash. Machine Yes [ ] No [ ]

Lot Area Ample.

Soil Characteristics _____


Application Rate _____

Topography _____

Depth to Water Table Repair.

Rock or other impervious formations _____

_____ Basement with Plumbing _____ Basement without Plumbing _____ No Basement _____ Crawl Space

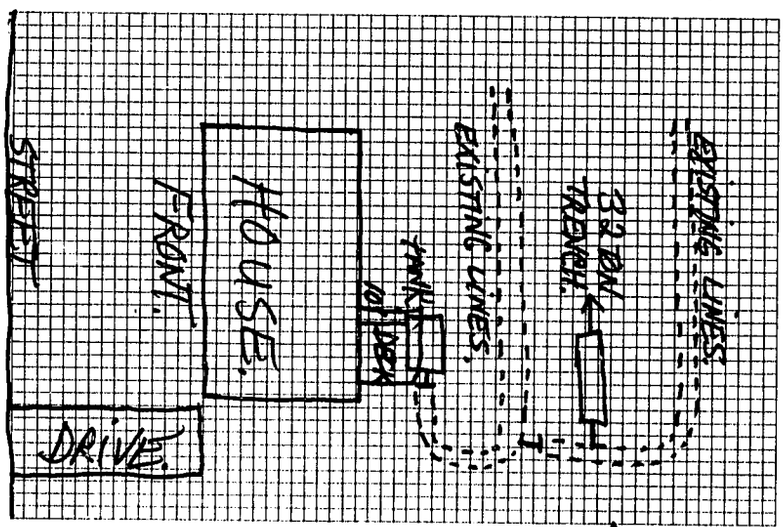

Plan of System (Not to Scale)

Size of Tank EXISTING. Gals.

Nitrification Field:

No. of Lines _____

Sq. Ft. _____ Linear Ft. _____

Depth of Stone in Lines _____

Water Supply: Individual [ ]

Public [✓]

32 TON SUBSURFACE TRENCH INSTALLED.

Installed by Bill & Tommy Culbertson

I understand and agree to install a septic tank system as specified on this Improvement Permit.

Signed: _____

(IMPROVEMENT PERMIT IS VALID FOR 60 MONTHS FROM DATE OF ISSUE.)

IMPROVEMENT PERMIT BY Steve Brown, Jack Moore

COMMENTS _____

CERTIFICATE OF COMPLETION BY Steve Brown DATE 4-24-92.

EXISTING SYSTEM CHECKED BY _____ DATE _____

CONSTRUCTION MUST COMPLY WITH ALL OTHER APPLICABLE STATE AND LOCAL REGULATIONS

Permit is VOID if any unauthorized changes are made in installation of system, and/or if any unapproved changes are made to the site, and/or if any false information is supplied toward securing Improvement Permit.

Health Dept. Copy: White Inspection Dept. Copy: Yellow Sanitarian's Copy: Pink Owner's Copy: Gold