IREDELL COUNTY HEALTH DEPARTMENT

Statesville Phone TR 3-7271 Mooresville Phone NO 3-1271

PERMIT TO INSTALL SEPTIC TANK

Permit NO. 78 Permit Date DEC. 11 1970

Owner HOPE Bros. Address STATESVILLE, N.C.

Installed By Adams Septic Tank Serv. Address TAYLORSVILLE N.C.

Location of Property Murdock Rd. - Turn LEFT on KING ST.


LOT. #12

Tank		Capacity		Length of Lines		Fixtures	
Block	( )	1000	(✓)	225'	( )	No. of Baths	(1)
Precast	(✓)	1250	( )	250'	( )	Dishwasher	( )
		1500	( )	Other 300		Garbage Grdr.	( )
		Other		700 SQ FT		Other	

NOTIFY HEALTH DEPARTMENT AT LEAST EIGHT HOURS BEFORE TANK IS TO BE INSPECTED.

Final Inspection DEC 11 1970 Approved (✓) Disapproved ( )

Remarks Community

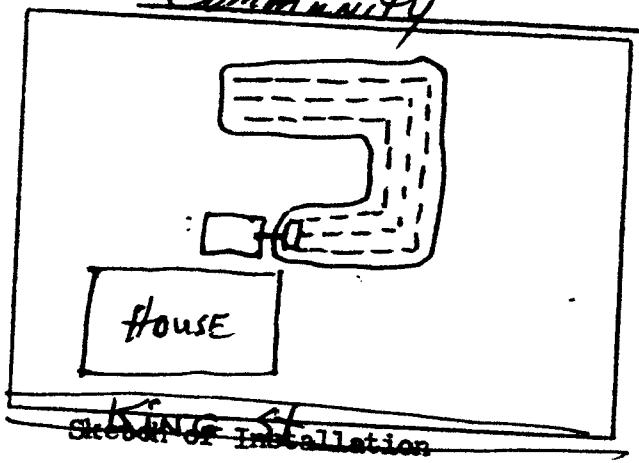

Sketch of Installation

Glenn Todd

Sanitarian