IREDELL COUNTY HEALTH DEPARTMENT

Statesville Phone TR 3-7271 Mooresville Phone NO 3-1271

PERMIT TO INSTALL SEPTIC TANK

Permit NO. 289 Permit Date April 29 1971

Owner Hope Bros. Bldrs INC Address Statesville, N.C.

Installed By Adams Address Taylorsville, NC

Location of Property King St. off Murdock Rd


Lot No. 32

Tank		Capacity		Length of Lines		Fixtures	
Block	( )	1000	(✓)	225'	(✓)	No. of Baths	(✓)
Precast	(✓)	1250	( )	250'	( )	Dishwasher	( )
		1500	( )	Other 300		Garbage Grdr.	( )
		Other				Other	

NOTIFY HEALTH DEPARTMENT AT LEAST EIGHT HOURS BEFORE TANK IS TO BE INSPECTED.

Final Inspection April 29 1971 Approved (✓) Disapproved ( )

Remarks Community WATER Supply

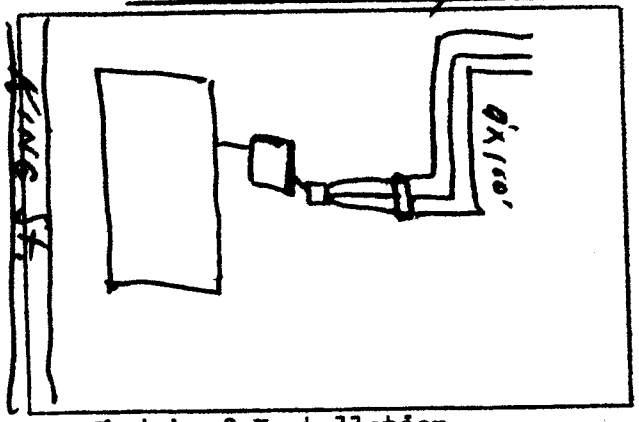

Sketch of Installation

Sanitarian