IREDELL COUNTY HEALTH DEPARTMENT

Statesville Phone TR 3-7271 Mooresville Phone NO 3-1271

PERMIT TO INSTALL SEPTIC TANK

Permit NO. 289 Permit Date April 29 1971

Owner Hope Bros - Builders Inc. Address Statesville, N.C.

Installed By Adams Address Taylorsville, N.C.

Location of Property King Street off Murdock Rd.


Lot No. 34

| Tank | | Capacity | | Length of Lines | | Fixtures | |
|---|---|---|---|---|---|---|---|
| Block | ( ) | 1000 | (✓) | 225' | ( ) | No. of Baths | (1) |
| Precast | (✓) | 1250 | ( ) | 250' | ( ) | Dishwasher | ( ) |
| | | 1500 | ( ) | Other 300' | | Garbage Grdr. | ( ) |
| | | Other | | | | Other | |

NOTIFY HEALTH DEPARTMENT AT LEAST EIGHT HOURS BEFORE TANK IS TO BE INSPECTED.

Final Inspection April 29 1971 Approved (✓) Disapproved ( )

Remarks Community water Supply

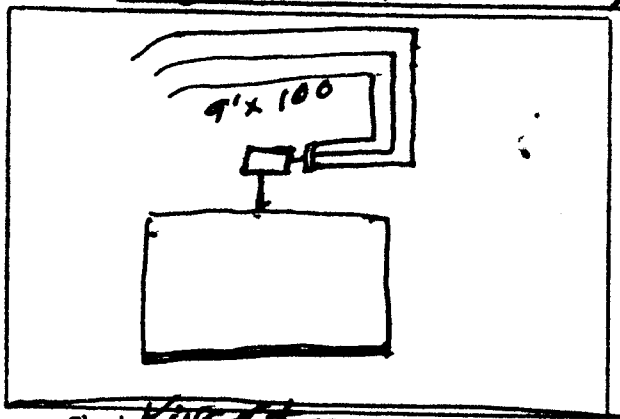


Sketch of Installation

Sanitarian