IREDELL COUNTY HEALTH DEPARTMENT - *ENVIRONMENTAL HEALTH* ☑ STATESVILLE OFFICE 704-878-5305 ☐ MOORESVILLE OFFICE 704-664-5281

IMPROVEMENT PERMIT / AUTHORIZATION TO CONSTRUCT / OPERATION PERMIT / EXISTING SYSTEM INSPECTION

PERMIT # Repair PIN # 4754443462 DATE 6-6-12

OWNER ~~Fletcher~~; Verla FLetcher APPLICANT: Della Reese PHONE: Home/Cell # 704-872-5249 Business # N/A

SITE ADDRESS 1097 King St. Statesville OWNER / APPLICANT ADDRESS 1097 King Street Statesville NC 28625

SITE DIRECTIONS G. Broad St.; Bon Eastside Dr.; (L) on Greenbriar Rd; (L) on King Street; Property on Right

SUBDIVISION Hope Brothers BLOCK / SECTION N/A LOT # 35 LOT AREA 0.325 acres DESIGN FLOW 360 gpd L.T.A.R. 0.25

Septic Tank Existing Gallons: STB ____ Date ____

Pump Tank ____ Gallons: P T ____ Date ____

Pump Make ____ Model ____ Serial # ____

No. Nitrification Fields: 1 No. Lines 5 Linear Feet 240

Trench Width 24" Max. Trench Bottom Depth 36" Gravel Depth N/A

☐ New System ☑ Repair ☐ Expansion System Type I II (III) IV V VI

System Description: N/A

Repair System Description: PPBPS / T+J Panel 50% Reduction

Maintenance Agreement Required ☐ YES ☑ NO

☑ GRAVITY ☐ PRESSURE

☑ Residence No. Bedrooms 3

☐ Business No. Persons ____

☐ Other No. Employees ____


☐ Slab ☑ Crawl Space

☐ Basement w/plumbing ☐ Basement w/o plumbing

Water Supply: ☐ Private ☑ Public ☐ Community

Comments / Conditions: Install a gravity 50% Reduction system on contour w/ Parallel distribution; Use effluent splitter such as Zoeller; Use 53 Panels

INITIAL SITE SKETCH

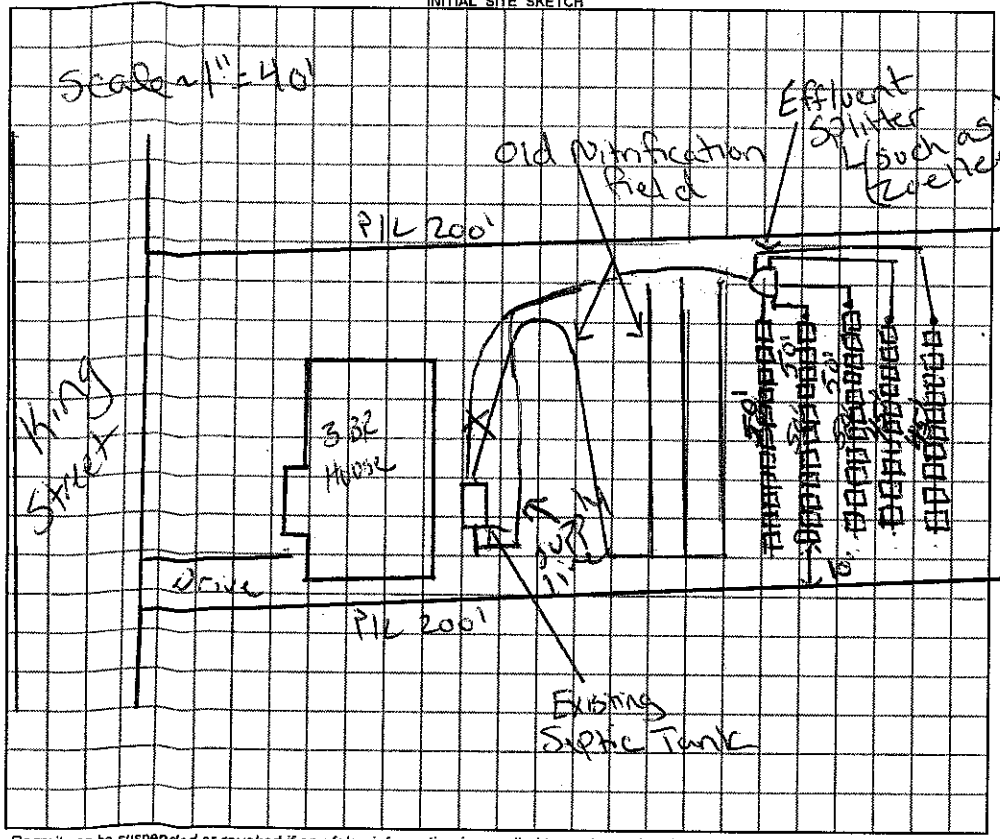

AS BUILT SKETCH

- Leak evident @ time of inspection.
- Installed as drawn

Permit can be suspended or revoked if any false information is supplied toward securing the permit / any unauthorized changes are made to the site / any unauthorized changes are made in the installation of the system.

☐ ***IMPROVEMENT PERMIT*** with plat valid without expiration. ☑ ***IMPROVEMENT PERMIT*** with plat ~~valid without expiration~~ site plan valid 60 mo. ☑ ***AUTHORIZATION TO CONSTRUCT*** valid for period equal to IMPROVEMENT PERMIT–not to exceed 60 mo.

Owner / Applicant Signature: Della Reese Date 6-6-12 Installed by: AJ Backhoe Service INC

IMPROVEMENT PERMIT by: Justin Henderson ***REHS*** Date 6-6-12 OPERATION PERMIT by: Justin Henderson ***REHS*** Date 7-16-12

AUTHORIZATION TO CONSTRUCT by: Justin Henderson ***REHS*** Date 6-6-12 Existing System Inspected by: ***REHS*** Date

YOU SHOULD CONTACT A LOCATOR SERVICE PRIOR TO ANY EXCAVATION

White Copy – Environmental Health YELLOW COPY (Final) Owner / Applicant PINK COPY (Initial) Owner / Applicant