IREDELL COUNTY HEALTH DEPARTMENT

Statesville Phone TR 3-7271 — Mooresville Phone NO 3-1271

PERMIT TO INSTALL SEPTIC TANK

Permit No. 291 — Permit Date April 30 1971

Owner Hope Bros. Black Inc — Address Statesville, NC

Installed By Adams — Address Taylorsville, NC

Location of Property King St. off Murdock Rd.


Lot No. 35

Tank		Capacity		Length of Lines		Fixtures	
Block	( )	1000	(✓)	225'	( )	No. of Baths	( )
Precast	(✓)	1250	( )	250'	( )	Dishwasher	( )
		1500	( )	Other 300		Garbage Grdr.	( )
		Other				Other	

NOTIFY HEALTH DEPARTMENT AT LEAST EIGHT HOURS BEFORE TANK IS TO BE INSPECTED.

Final Inspection April 30 1971 — Approved (✓) Disapproved ( )

Remarks Community Water Supply

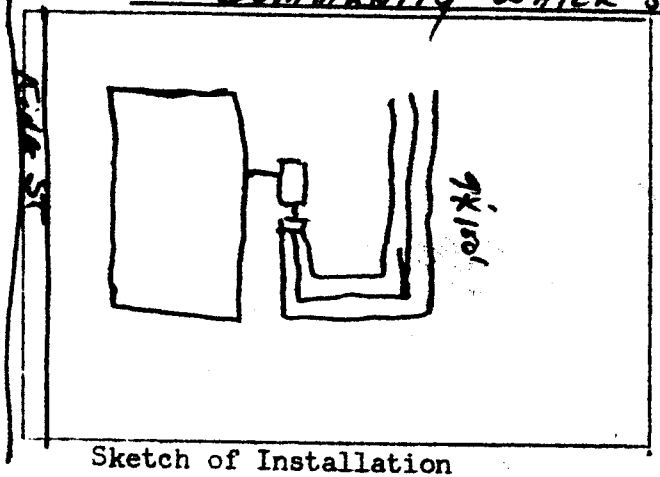

Sketch of Installation

Sanitarian