IREDELL COUNTY HEALTH DEPARTMENT

Statesville Phone TR 3-7271 Mooresville Phone NO 3-1271

PERMIT TO INSTALL SEPTIC TANK

Permit No. 386 Permit Date _____ 19__

Owner Hope Brother's Address Statesville, N.C.

Installed By Floyd Adams Address Taylorsville, N.C.


Location of Property Hgwy 70 E. Turn of Murdock Rd. (2320). Go King St. (2459). Turn left, last house on right.

Tank		Capacity		Length of Lines		Fixtures	
Block	( )	1000	(✓)	225'	( )	No. of Baths	(1)
Precast	(✓)	1250	( )	250'	(✓)	Dishwasher	( )
		1500	( )	Other 300		Garbage Grdr.	( )
		Other 900 sq. ft.				Other	

NOTIFY HEALTH DEPARTMENT AT LEAST EIGHT HOURS BEFORE TANK IS TO BE INSPECTED.

Final Inspection 11-11- 1970 Approved (✓) Disapproved ( )

Remarks _____

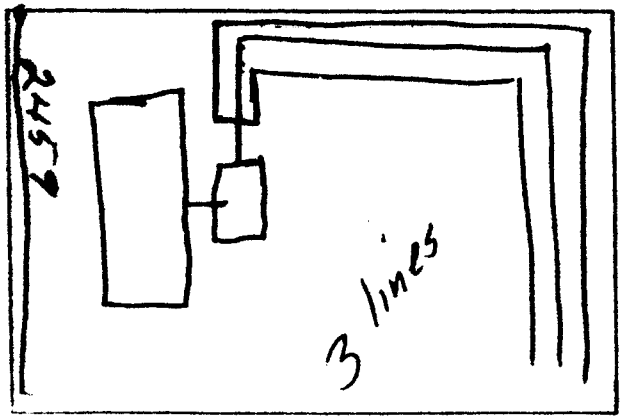

Sketch of Installation

Cross S. Ware

Sanitarian