IREDELL COUNTY HEALTH DEPARTMENT

Statesville Phone TR 3-7271 Mooresville Phone NO 3-1271

PERMIT TO INSTALL SEPTIC TANK

Permit No. 119 Permit Date _____ 19__

Owner Hope Brothers Address Statesville

Installed By Floyd Adams Address Taylorsville


Location of Property Murdock Rd to King St. Last House on right.

Tank		Capacity		Length of Lines		Fixtures	
Block	( )	1000	( )	225'	( )	No. of Baths	(2)
Precast	(✓)	1250	( )	250'	( )	Dishwasher	( )
		1500	( )	Other _____		Garbage Grdr.	( )
		Other _____				Other _____	

NOTIFY HEALTH DEPARTMENT AT LEAST EIGHT HOURS BEFORE TANK IS TO BE INSPECTED.

Final Inspection 1-14- 1971 Approved (✓) Disapproved ( )

Remarks Not much fall from tank

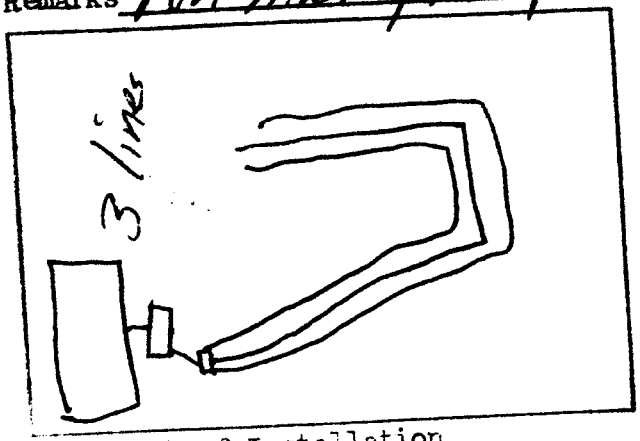

Sketch of Installation

Cross S. Hall

Sanitarian