# IREDELL COUNTY HEALTH DEPARTMENT

STATESVILLE 704-878-5305 MOORESVILLE 704-664-5281

1:00

## IMPROVEMENT PERMIT / AUTHORIZATION TO CONSTRUCT / OPERATION PERMIT / EXISTING SYSTEM INSPECTION

PERMIT# 69073 PIN#

OWNER OR CONTRACTOR Norman Hope PHONE: Business 872-0028 Home DATE 3-23-98

ADDRESS 719 Stonecrest Dr. Statesville

LOCATION

SUBDIVISION Stonecrest BLOCK / SECTION LOT 72 LOT AREA 15000 sq'± SITE CLASS. PS DESIGN FLOW 360 L.T.A.R. .3

Septic Tank: 1000 Gallons; STB 1012 Date 4-1-98
Pump Tank: 1000 Gallons; PT 17 Date 9-24-97
Pump Make: Hydromatic Model Shd 50 Serial No. 1/2 HP
Nitrification Field: No. Fields 1 Square Feet 400 Linear Feet 200
No Lines 4 Trench Width 24 Max Trench Bottom Depth 36 Gravel Depth N/A

☑ New System ☐ Repair System Type: I, II, III, IV, V, VI
System Description: Pump To Panels
Repair System Description: " " "
Maintenance Agreement Required: ☑ Yes ☐ No


☑ House/Mod. Home No. Bedrooms 3
☐ Mobile Home No. Bathrooms 2
☐ Business No. Employees
☐ Other
☐ Slab ☑ Crawl Space ☐ Basement w/plumbing ☐ Basement wo/plumbing

Water Supply: ☐ Individual ☑ Public ☐ Community

Comments:/Conditions: See Attached Sheets for Pump Tank & Pressure line Set up which are part of this Permit.

Comments:/Conditions: Before operations can be issued Certified operator will have to be on Contract Copy must be Provided To Health Dept.

INITIAL SITE SKETCH

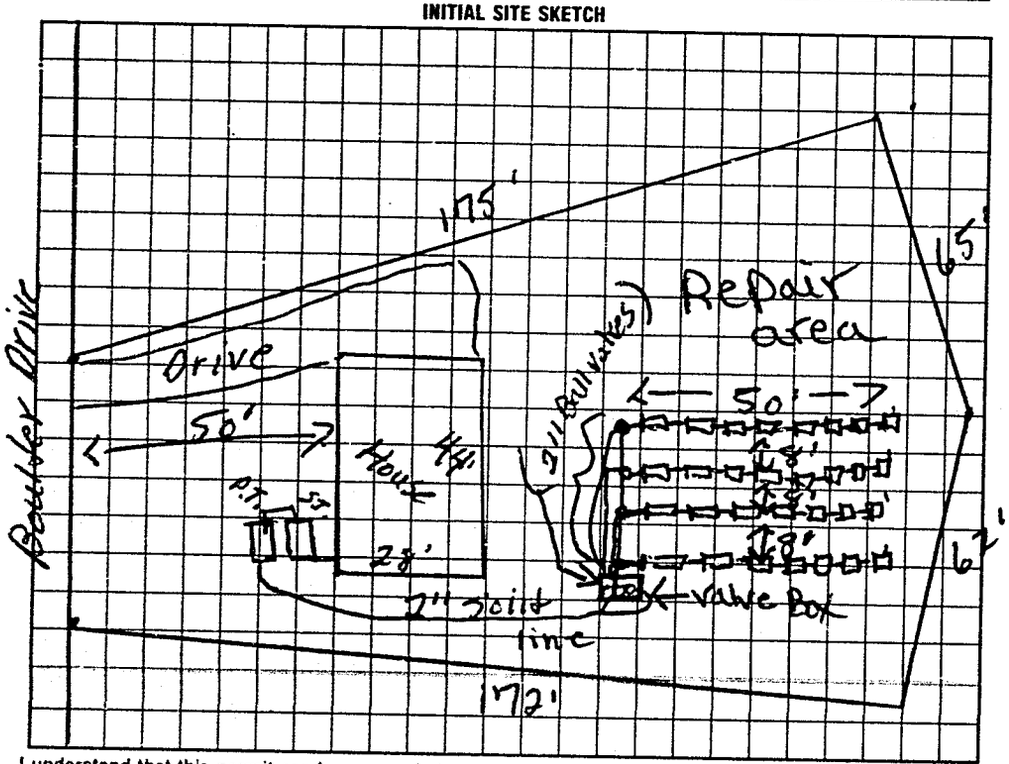


AS BUILT SKETCH

Inspected ST, PT, & Drain lines 6-5-98 JCM

Pressure Test & Draw Down 8-6-98 JCM wiring was unacceptable

I understand that this permit can be suspended or revoked if any false information is supplied toward securing the permit/any unauthorized changes are made to the site/any unauthorized changes are made in the installation of the system. Improvement Permit with plat valid without expiration. Improvement Permit with site plan valid for sixty months. Authorization to Construct is valid for a period equal to that of Improvement Permit – not to exceed sixty months.

Signed: Norman Hope date

Installed by: Forest Shuford

Improvement Permit by: J.C. Moore date 3-23-98

Operation Permit by: J.C. Moore date 9-23-98

Authorization to Construct by: J.C. Moore date 3-23-98

Existing System Inspection by: date

HEALTH DEPT. COPY WHITE — INSPECTION COPY (FINAL) GREEN — OWNER COPY (FINAL) YELLOW — INSPECTION COPY (INITIAL) PINK — OWNER COPY (INITIAL) GOLD