IREDELL COUNTY HEALTH DEPARTMENT

STATESVILLE 704-878-5305 (C1) MOORESVILLE 704-664-5281

IMPROVEMENT PERMIT / AUTHORIZATION TO CONSTRUCT / OPERATION PERMIT / EXISTING SYSTEM INSPECTION

PERMIT# 121180 PIN# 4754-~~43-8787~~ 44-9116 DATE 6-4-09

OWNER OR CONTRACTOR DEBORAH DAYE PHONE: Business 704-657-1704 Home 704-546-2409

ADDRESS 1156 MAHOGANY ROAD, STATESVILLE, NC 28625

LOCATION EASTSIDE DRIVE TO GREENBRIAR ROAD TL MAHOGANY ROAD, TL PRIVATE DRIVE AT CURVE ~700' BACK

SUBDIVISION ABSHER BLOCK / SECTION _____ LOT 17(pt) LOT AREA 0.500 ACRE SITE CLASS PS DESIGN FLOW 360 L.T.A.R. 0.30 gpd/ft²

Septic Tank: 1000 Gallons; STB 1012 Date 3-7-09
Pump Tank: _____ Gallons; PT _____ Date _____
Pump Make: _____ Model _____ Serial No. _____
Nitrification Field: No Fields 1 Square Feet 1200 Linear Feet 400
No Lines FOUR Trench Width 36" Max Trench Bottom Depth 36" Gravel Depth 12"

☑ New System ☐ Repair System Type: I (II) III, IV, V, VI
System Description: CONVENTIONAL GRAVITY
Repair System Description: SD2 REDUCTION, GRAVITY
Maintenance Agreement Required: ☐ Yes ☑ No


☐ House/Mod. Home ☑ Mobile Home ☐ Business ☐ Other
No. Bedrooms 3 No. Bathrooms 2 No. Employees ____
☐ Slab ☑ Crawl Space ☐ Basement w/plumbing ☐ Basement wo/plumbing

Water Supply: ☑ Individual ☐ Public ☐ Community WELL

Comments:/Conditions: INSTALL LINES ON CONTOUR AS SHOWN. CONTACT HEALTH DEPT. AFTER CLEARING TO FLAG SYSTEM IF NEEDED.

Comments:/Conditions: SEPTIC TANK WITH MARKER INSTALLED USING "THETITE" FILTER

INITIAL SITE SKETCH SCALE: 1" = 40'

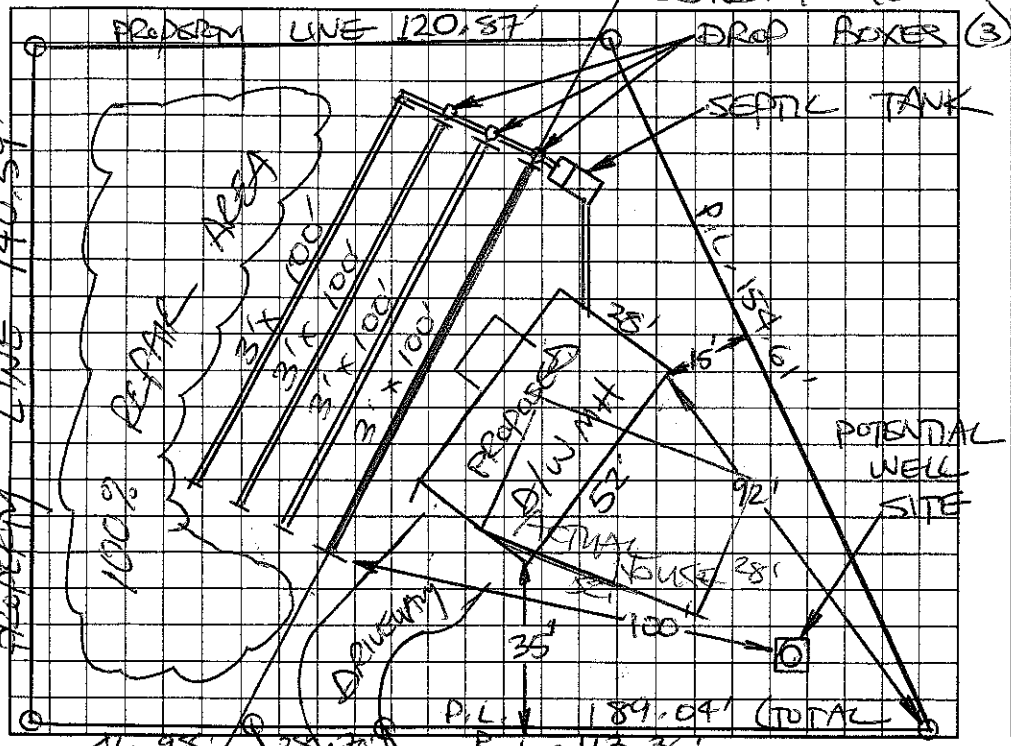

AS BUILT SKETCH

SYSTEM INSTALLED ACCORDING TO INITAL SITE SKETCH

Permit can be suspended or revoked if any false information is supplied toward securing the permit/any unauthorized changes are made to the site/any unauthorized changes are made in the installation of the system. Improvement Permit with plat valid without expiration. Improvement Permit with site plan valid for sixty months. Authorization to Construct is valid for a period equal to that of Improvement Permit -- not to exceed sixty months.

Signed: Deborah Daye date 6/4/09 Installed by: A-1 BACKHOE

Improvement Permit by: STEVE HEDRICK date 6-4-09 Operation Permit by: STEVE HEDRICK date 8-9-09

Authorization to Construct by: STEVE HEDRICK date 6-4-09 Existing System Inspection by: _____ date _____

HEALTH DEPT. COPY: WHITE OWNER COPY (FINAL): YELLOW OWNER COPY (INITIAL): PINK