ICHD - ENVIRONMENTAL HEALTH DIVISION

Statesville Office (704) 878-5305 x3456 | Mooresville Office (704) 660-3625 | HS

PERMIT : OSWP 2024-64845

SEPTIC: IMPROVEMENT PERMIT / AUTHORIZATION TO CONSTRUCT / OPERATION PERMIT / EXISTING SYSTEM

PIN # 4754 -- 45 -- 0112

APPLICANT/OWNER: Russell B. Williams | APPLICANT ADDRESS: 4919 E. Maiden Rd, Maiden NC 28650

SITE ADDRESS: 752 Stoney Ln, Statesville NC 28625 | PHONE: (980) 429-1580 | ALT. PHONE —

SITE DIRECTIONS: E Broad St → Safrit Rd → Japul Rd → Beauty St → Stonecrest Dr → Lot on (R) | SAP CONTROLLED: ~~YES~~ ~~NO~~ Existing

SUBDIVISION: Hope Bros Builders | SECTION: — | LOT # 111 | LOT AREA: — | DESIGN FLOW: Ex | L.T.A.R.(Initial): Ex | L.T.A.R (Repair): Ex

Septic Tank	1000	(gal)	STB 760	Date					
Pump Tank	—	(gal)	PT —	Date	—				
Pump Make	—	Model	—	Serial #	—				
# Nitrification Fields	Ex	# Lines	Ex	Linear Ft	Ex				
Trench Width	Ex	*Max. Trench Depth(Initial)	Ex	*Max. Trench Depth(Repair)	Ex	Gravel Depth	Ex		

* Measured on the downhill side of the trench

☐ New System ☑ Repair ☐ Expansion | System Type: I ☐ II III IV V VI

System Description: Conventional

Repair System Description: Tank Replacement

Maintenance Agreement Required: ☐ YES ☑ NO

☑ GRAVITY ☐ PRESSURE

Effluent Standard: ☒ DSE ☐ HSE ☐ TS-I ☐ TS-II ☐ RCW ☐ NSF/ANSI 40

Usable Depth to LC (Initial): —

☑ Residence | No. Bedrooms 3

☐ Business | No. Persons 6

☐ Other | No. Employees —

☐ Slab | ☑ Crawl Space


☐ Basement w/plumbing | ☐ Basement w/o plumbing

Usable Depth to LC (Repair): — *Limiting Condition*

Water Supply: ☐ Private ☑ Public ☐ Community

Comments / Conditions: Pump, crush & fill old Septic Tank

INITIAL SITE SKETCH

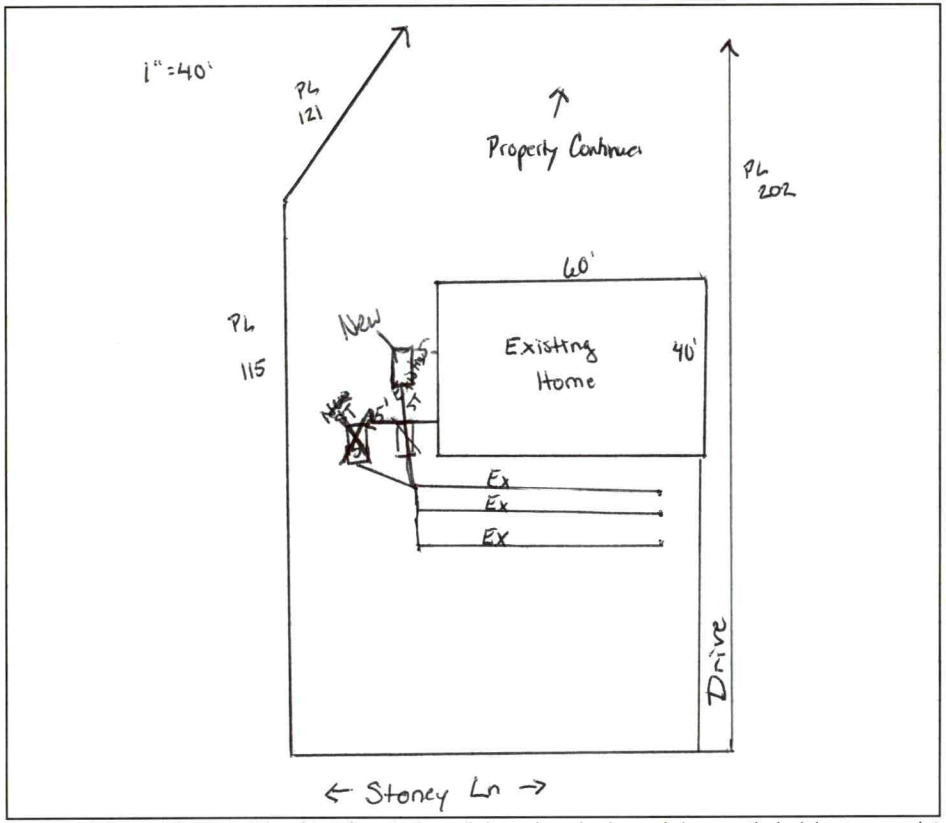

AS BUILT SKETCH

FOR SEPTIC FINAL INSPECTION CALL: 704-664-3703 between 8am-9am

the day the inspection is needed. Be sure to speak with an inspector to confirm your time.

Installed as Drawn

Permit can be suspended or revoked if any false information is supplied toward securing the permit / any unauthorized changes are made to the site / any unauthorized changes are made in the installation of the system. **CONTACT A LOCATOR SERVICE PRIOR TO ANY EXCAVATION**

☑ **IMPROVEMENT PERMIT *with plat*** *valid without expiration.* ☑ **IMPROVEMENT PERMIT *with site plan*** *valid for 60 mos.* ☑ **AUTHORIZATION TO CONSTRUCT** *valid for period equal to IMPROVEMENT PERMIT--not to exceed 60 mo.*

Owner / Applicant Signature: ONLINE | Date: | Installed by: Russell Williams

IMPROVEMENT PERMIT by: [signature] | Date: 11/27/24 | OPERATION PERMIT by: [signature] | Date: 12/6/24

AUTHORIZATION TO CONSTRUCT by: [signature] | Date: 11/27/24 | Existing System Inspected by: | Date:

Item	Date	Initials
Drain Lines Checked		
Tanks Checked		
Pressure Manifold or Valve Box Checked		
Pressure Head Set		
Electrical Checked		
Floats Set		
Alarm Checked		
Maintenance Contract Needed? Y / N		
Comments:		

Repairs Only	
	State Code
Failing System Code	
Type of Distribution	G or P
Type of Failure/Malfunction	
Primary Cause of Failure/Malfunction	
Age of System? _____	
Initial or Repair? _____	

PERMIT SNAPSHOT REPORT OSWP-2024-64845 FOR IREDELL COUNTY

Permit Type:	Environmental Health OSWP	**Project:**		**App Date:**	11/06/2024
Work Class:	EH Septic Permit	**District:**	Statesville	**Exp Date:**	NOT AVAILABLE
Status:	PRIORITY PERMIT	**Square Feet:**	0.00	**Completed:**	NOT COMPLETED
Valuation:	$0.00	**Assigned To:**	Moore, Bradley	**Approval Expire Date:**	
Description:	Repair Tank; TANK CAVED IN				

Parcel: 4754450112.000 Main	**Address:** 752 Stoney Statesville, NC 28625 Main	**Zone:** R-15(Urban Fringe Low Density Residenti

Applicant/Authorized Agent
Russell B Williams
4919 E Maiden Rd 4919 E
MAIDEN RD.
Maiden, NC 28650
Business: (980) 429-1580

Applicant/Authorized Agent
Russell B Williams
4919 E Maiden Rd 4919 E
MAIDEN RD.
Maiden, NC 28650
Business: (980) 429-1580

Property Owner
Matthew Elrod
Mobile: (404) 561-1511

Permit Custom Fields

How is your site plan being submitted	Custom Site Plan	Septic Application/Permit Type	Repair	Does the site contain any jurisdictional wetlands	No
Non-domestic Sewage Generated	No	Other Public Agency	No	All proposed structure dimensions	Existing House
Type of New Single-Family Residence	Stick Built	Maximum Number of Bedrooms	3	If other Addition/Structure, please explain	
Number of Occupants	6	Foundation Type	Crawl Space Foundation	Water Supply	Municipal Water
Desired Septic System Type	Other	If other septic system type, please explain	New Tank only	Pump Make	
# of Nitrification Fields		Model		Serial #	
System Description		Repair System Description		Comments/Conditions	
Permit type(s)	Authorization to Construct	Additional Unique Setbacks Apply	No		

Attachment File Name	Added On	Added By	Attachment Group	Notes
Signature_Russell_Williams_11/6/2024.jpg	11/06/2024 14:25	Williams, Russell		Uploaded via CSS
752 Stoney Repair App Authorization_v1.pdf	11/19/2024 16:55	Williams, Russell	Available Online	
752 Stoney_v1.pdf	11/19/2024 16:55	Williams, Russell	Available Online	

Workflow Step / Action Name	Action Type	Start Date	End Date
Application Completeness Check v.1		11/19/2024 16:55	11/19/2024 16:55
Confirm application complete v.1	Generic Action		11/19/2024 16:55
Lot Readiness Verification v.1			
~~OSWP Septic Preliminary Site Visit v.1~~	Inspection		11/19/2024 16:55
OSWP Site Evaluation v.1	Inspection		
~~**Zoning Review v.1**~~			11/19/2024 16:55
~~Floodplain Admin Overview v.1~~	Task		11/19/2024 16:55
~~Statesville Zoning Approval v.1~~	Task		11/19/2024 16:55
~~Issue Invoice v.1~~	Generic Action		11/19/2024 16:55
~~Fees Paid v.1~~	Generic Action		11/19/2024 16:55
Fees v.1			
Issue Invoice v.1	Generic Action		
Fees Paid v.1	Generic Action		