IREDELL COUNTY HEALTH DEPARTMENT

Statesville Phone TR 3-7271 Mooresville Phone No. 664-5281

PERMIT TO INSTALL SEPTIC TANK

Permit No. 47 Permit Date 6-12 1975

Owner Bldr. Wayne Pope Address Statesville

Installed By Icenhour Bldr. Address Statesville


Location of Property East Broad St. Right at Dal-Wan Terrace Dr.

Tank		Capacity		Length of Lines		Fixtures	
Block	( )	1000	( )	225'	( )	No. of Baths	(2)
Precast	(✓)	1250	(✓)	250'	( )	Dishwasher	(✓)
		1500	( )	Other 253		Garbage Grdr.	(✓)
		Other				Other	

NOTIFY HEALTH DEPARTMENT AT LEAST EIGHT HOURS BEFORE TANK IS TO BE INSPECTED.

Final Inspection 6-12 1978 Approved (✓) Disapproved ( )

Remarks Water Supply City of Statesville

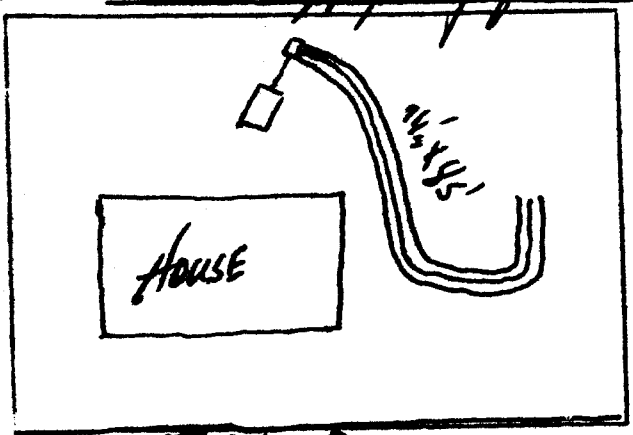

Sketch of Installation

Sanitarian