A-1

IREDELL COUNTY HEALTH DEPARTMENT

STATESVILLE 704-878-5305 MOORESVILLE 704-664-5281

IMPROVEMENT PERMIT / CERTIFICATE OF COMPLETION / OPERATION PERMIT / EXISTING SYSTEM INSPECTION

PROPERTY DESCRIPTION NO. Statesville DATE 11-17-97 TAX MAP NO. 4754-52-3222 Watershed: ☐ Yes ☐ No

OWNER OR CONTRACTOR Jermiah Anderson + Pamela PHONE: Business Home 873 1586

ADDRESS 121 mt. olive Rd

LOCATION Greenbrair Rd Turn mt olive Rd 1/8 mi Left back OFF Rd

SUBDIVISION Betty Evans Property BLOCK / SECTION LOT 4 LOT AREA 3.6 acres SITE CLASS. PS DESIGN FLOW 360 L.T.A.R. .13

Septic Tank: 1060 Gallons; STB Date

Pump Tank: Gallons; PT Date

Pump Make: Model Serial No.

Nitrification Field: No Fields 1 Square Feet 1200 Linear Feet 400

No Lines 4 Trench Width 36" Max Trench Bottom Depth 36" Gravel Depth 12"

☑ New System ☐ Repair System Type: I II III, IV, V, VI

System Description: Conv. Gravity

Repair System Description: 11 11

Maintenance Agreement Required: ☐ Yes ☑ No

☐ House/Mod. Home No. Bedrooms 3

☐ Mobile Home No. Bathrooms 2

☐ Business No. Employees

☐ Other

☐ Slab ☐ Crawl Space ☐ Basement w/plumbing ☐ Basement wo/plumbing


Water Supply: ☑ Individual ☐ Community ☐ Public

Comments:

← To mt olive Rd


R/W

INITIAL SITE SKETCH

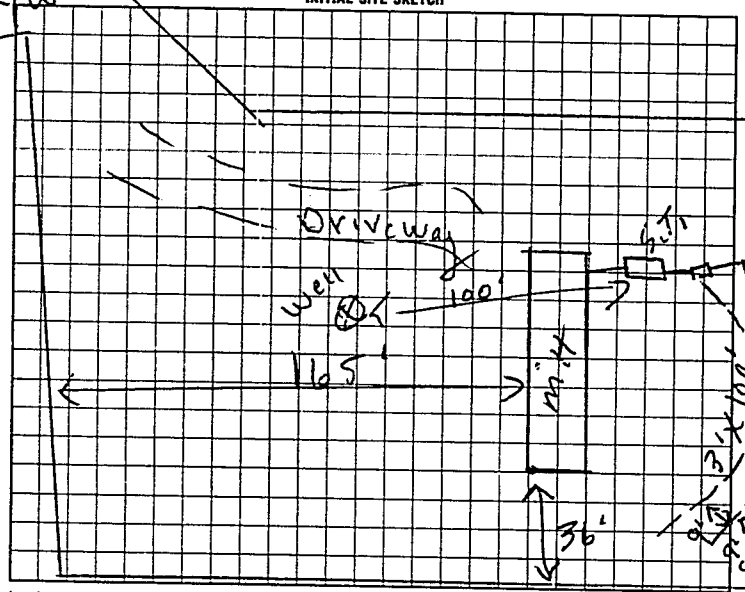

Comments:

AS BUILT SKETCH

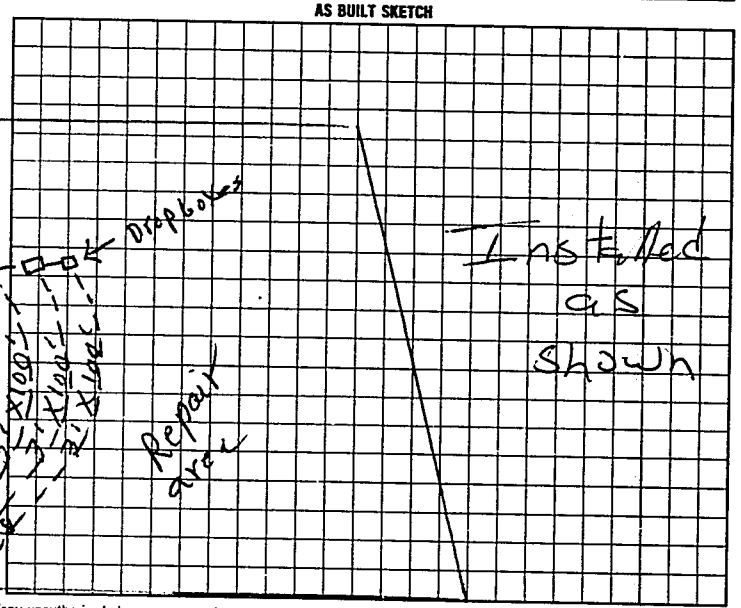

I understand that this permit can be suspended or revoked if any false information is supplied toward securing the permit/any unauthorized changes are made to the site/any unauthorized changes are made in the installation of the system. Improvement Permit is valid for 60 months from date of issuance.

Signed: x Jeremiah Anderson

Improvement Permit by: L. C. moore date 11-17-97

Existing System Inspected by: L. C. moore date 11-17-97

Installed by: A-1 Backhoe

Certificate of Completion by: date

Operation Permit by: Mat Cauthen date 3-26-98

Authorization to Const. EXPIRES 60 mos from issue

*0 Const.

INSPECTOR COPY (WHITE) INSPECTOR COPY (FINAL) GREEN OWNER COPY (FINAL) YELLOW INSPECTOR COPY (INITIAL) PINK OWNER COPY (INITIAL) GOLD

9 2 5 2 0 0