78006

IREDELL COUNTY HEALTH DEPARTMENT

STATESVILLE 704-878-5305 MOORESVILLE 704-664-5281

IMPROVEMENT PERMIT / AUTHORIZATION TO CONSTRUCT / OPERATION PERMIT / EXISTING SYSTEM INSPECTION

PERMIT# STATESVILLE PIN# 4754 53 4219

OWNER OR CONTRACTOR LORI SCOTT DATE 10-29-98

ADDRESS 1160 MAHOGANY ROAD, STATESVILLE, NC. PHONE: Business Home 924-7183

LOCATION E. GREENBRIAR ROAD TO MAHOGANY ROAD, ON LEFT AT FIRST CURVE

SUBDIVISION BLOCK / SECTION LOT LOT AREA 2.56 ACRES SITE CLASS PS DESIGN FLOW 480 L.T.A.R. 0.4 (EXISTING)

Septic Tank: 1000 Gallons; STB Date

Pump Tank: Gallons; PT Date

Pump Make: Model Serial No.

Nitrification Field: No Fields 1 Square Feet 300 Linear Feet 100

No Lines 1 Trench Width 36" Max Trench Bottom Depth 36" Gravel Depth 12"

☑ New System ☐ Repair System Type: I, II, III, IV, V, VI

System Description: CONVENTIONAL GRAVITY

Repair System Description: CONV. GRAVITY

Maintenance Agreement Required: ☐ Yes ☑ No

☐ Slab ☐ Crawl Space ☐ Basement w/plumbing ☐ Basement wo/plumbing

☐ House/Mod. Home No. Bedrooms 4

☑ Mobile Home No. Bathrooms 2

☐ Business No. Employees


☐ Other

Water Supply: ☐ Individual ☑ Public ☐ Community

Comments:/Conditions: INSTALL NEW DISTRIBUTION BOX AT THIRD LINE AS SHOWN TO SERIALLY FEED NEW 3'X100' LINE AS SHOWN

Comments:/Conditions:

INITIAL SITE SKETCH SCALE: 1"=40'

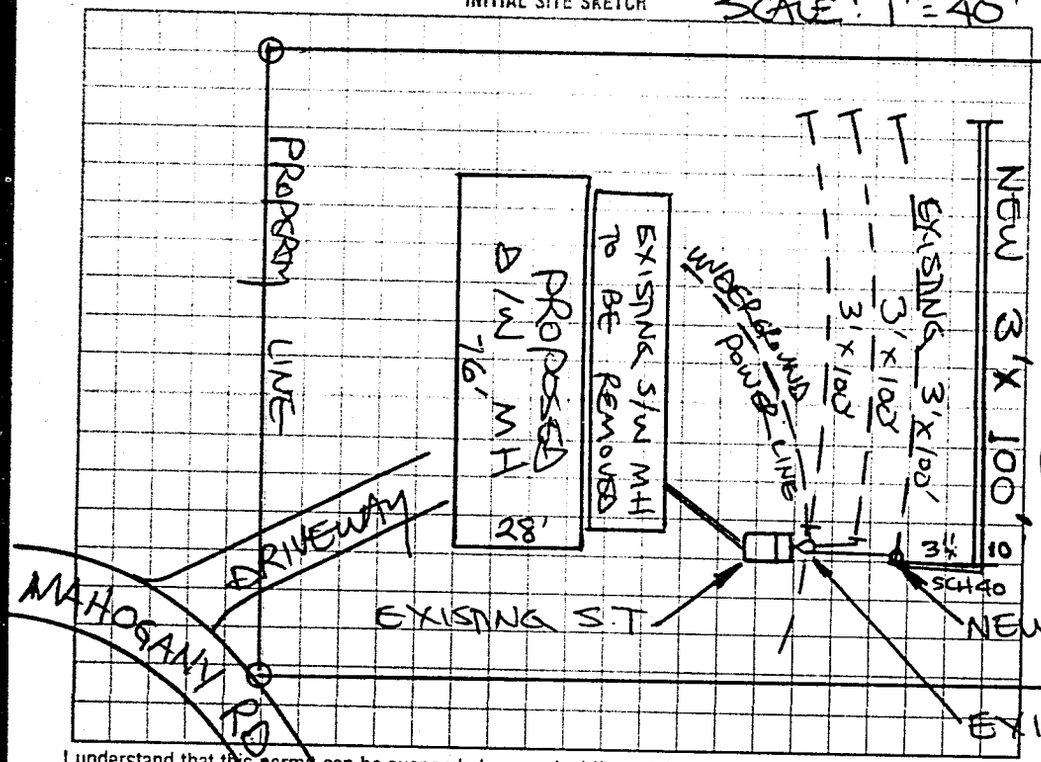

AS BUILT SKETCH

Same as initial sketch

I understand that this permit can be suspended or revoked if any false information is supplied toward securing the permit/any unauthorized changes are made to the site/any unauthorized changes are made in the installation of the system. Improvement Permit with plat valid without expiration. Improvement Permit with site plan valid for sixty months. Authorization to Construct is valid for a period equal to that of Improvement Permit – not to exceed sixty months.

Signed: Lori Scott date 10-29-98 Installed by: A-1 Backhoe

Improvement Permit by: STEVE HEDRICK date 10-29-98 Operation Permit by: L. C. Moore date 12-2-98

Authorization to Construct by: STEVE HEDRICK date 10-29-98 Existing System Inspection by: date

HEALTH DEPT. COPY: WHITE INSPECTION COPY (FINAL): GREEN OWNER COPY (FINAL): YELLOW INSPECTION COPY (INITIAL): PINK OWNER COPY (INITIAL): GOLD