IREDELL COUNTY HEALTH DEPARTMENT

STATESVILLE 704-878-5305 MOORESVILLE 704-664-5281

IMPROVEMENT PERMIT / AUTHORIZATION TO CONSTRUCT / OPERATION PERMIT / EXISTING SYSTEM INSPECTION

PERMIT# 076979 PIN# 4754 53 3953

OWNER OR CONTRACTOR ERICA GAMBLE PHONE: Business DATE 10-29-98

ADDRESS 309 VALLEY ROCK LANE TROUTMAN, NC 28166 Home 528-0145

LOCATION E: GREENBRIAR ROAD TO MAHOGANY ROAD, ON LEFT PAST 1ST CURVE

SUBDIVISION BLOCK / SECTION LOT 15 LOT AREA 0.91 ACRE SITE CLASS. PS DESIGN FLOW 360 L.T.A.R. 0.33 gpd/ft²

Septic Tank: 1000 Gallons; STB 1012 Date 9-7-98
Pump Tank: Gallons; PT Date
Pump Make: Model Serial No.
Nitrification Field: No Fields Square Feet 1080 Linear Feet 360
No Lines SIX Trench Width 36" Max Trench Bottom Depth 36" Gravel Depth 12"

☑ New System ☐ Repair System Type: I, II, III, IV, V, VI
System Description: CONVENTIONAL GRAVITY
Repair System Description: CONV. GRAVITY
Maintenance Agreement Required: ☐ Yes ☑ No


☐ House/Mod. Home ☑ Mobile Home ☐ Business ☐ Other
No. Bedrooms 3 No. Bathrooms 2 No. Employees
☐ Slab ☑ Crawl Space ☐ Basement w/plumbing ☐ Basement wo/plumbing

Water Supply: ☐ Individual ☑ Public ☐ Community


Comments:/Conditions: USE ONE FLOW DIVIDER TEE TO ACHIEVE EQUAL DISTRIBUTION INTO TWO SERIES OF DROP BOXES FEEDING THREE LINES EACH AS FLAGGED ON SITE

Comments:/Conditions:

INITIAL SITE SKETCH SCALE: 1"=40'

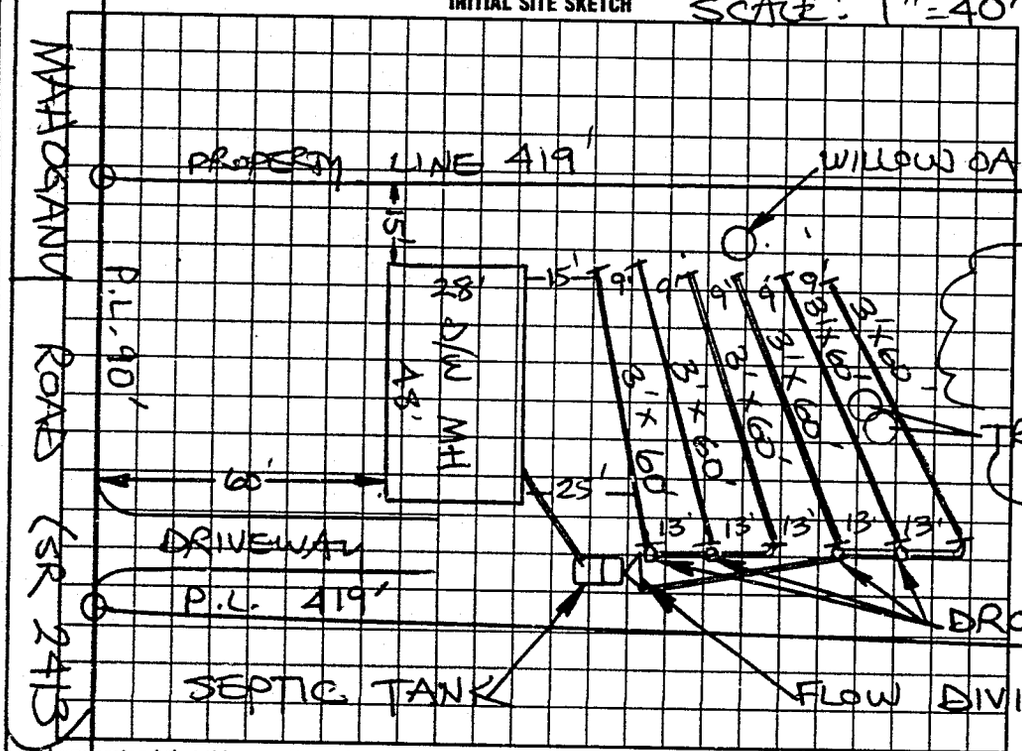

AS BUILT SKETCH

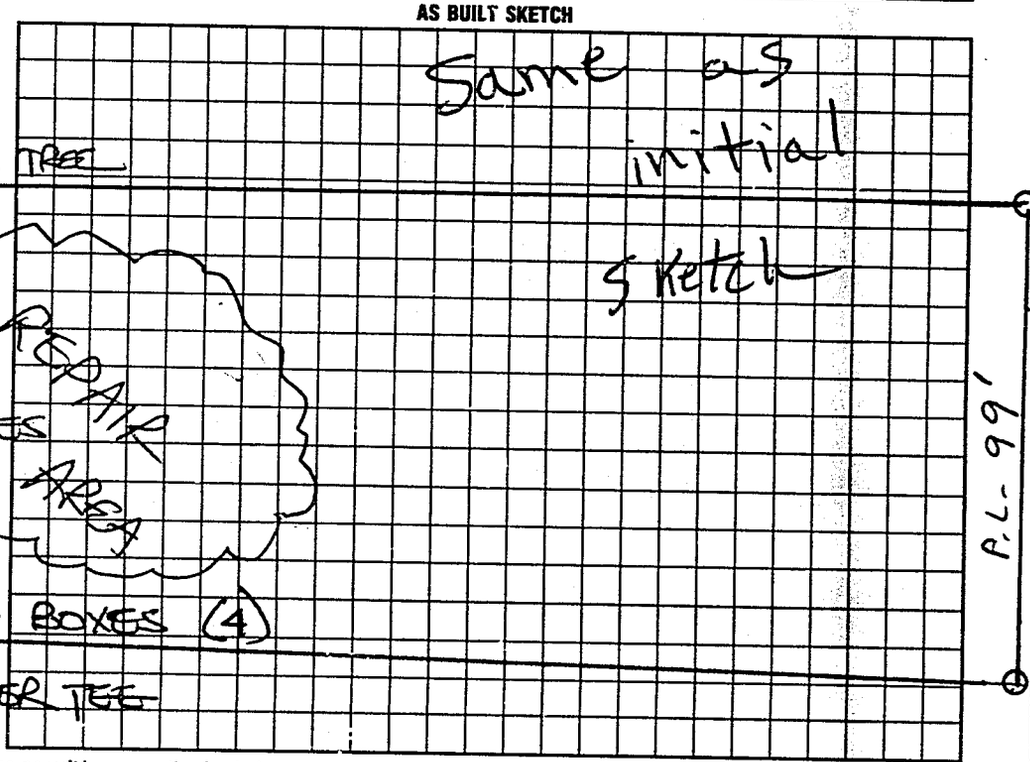

I understand that this permit can be suspended or revoked if any false information is supplied toward securing the permit/any unauthorized changes are made to the site/any unauthorized changes are made in the installation of the system. Improvement Permit with plat valid without expiration. Improvement Permit with site plan valid for sixty months. Authorization to Construct is valid for a period equal to that of Improvement Permit – not to exceed sixty months.

Signed: Michael Summers date 10-29-98

Improvement Permit by: STEVE HENDRICK date 10-29-98

Authorization to Construct by: STEVE HENDRICK date 10-29-98

Installed by: A-1 Backhoe

Operation Permit by: J.C. Moore date 11-4-98

Existing System Inspection by: date

HEALTH DEPT. COPY: WHITE INSPECTION COPY (FINAL): GREEN OWNER COPY (FINAL): YELLOW INSPECTION COPY (INITIAL): PINK OWNER COPY (INITIAL): GOLD