IREDELL COUNTY HEALTH DEPARTMENT

Statesville Phone TR 3-7271 Mooresville Phone NO 3-1271

PERMIT TO INSTALL SEPTIC TANK

Permit NO. _____ Permit Date June 16 1959

Owner Palmes & Asber - C.f. Little Address Belmont Rd

Installed By CLYDE HOKE Address _____

Location of Property on right before end of pavement.


#2

Tank		Capacity		Length of Lines		Fixtures	
Block	( )	800	(✓)	150'	(✓)	No. of Baths	( )
Precast	( )	900	( )	175'	( )	Dishwasher	( )
TANK built		1000	( )	200'	( )	Garbage Grdr.	( )
		1100	( )	225'	( )	Auto-Washer	( )
by C f Little		1200	( )	250'	( )	Other _____	
		Other _____		Other _____			

NOTIFY HEALTH DEPARTMENT AT LEAST EIGHT HOURS BEFORE TANK IS TO BE INSPECTED.

Final Inspection _____ 195__ Approved ( ) Disapproved ( )

Remarks Not for WASHER - central water system self Apl

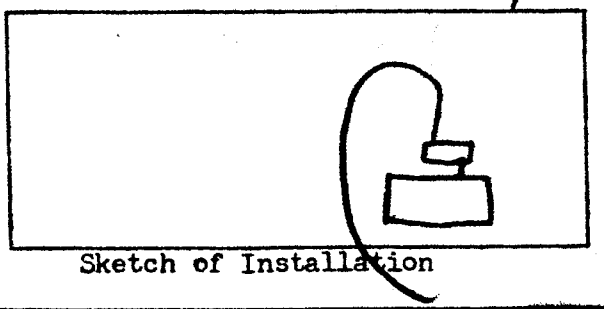

Sketch of Installation

Ralph A Thomas

Sanitarian