Could not Locate

# IREDELL COUNTY HEALTH DEPARTMENT

STATESVILLE 704-878-5305 MOORESVILLE 704-664-5281

## IMPROVEMENT PERMIT / CERTIFICATE OF COMPLETION / OPERATION PERMIT / EXISTING SYSTEM INSPECTION

PROPERTY DESCRIPTION NO. City DATE 10-14-93 TAX MAP NO. 5 T-10-A-111 Watershed: ☐ Yes ☒ No

OWNER OR CONTRACTOR Derick Leroy Summers PHONE: Business _____ Home _____

ADDRESS 331 Salisbury Rd

LOCATION East Greenbrair Turn on mahagony Drive 1/4 mi on left at 1172 mahagony Dr.

SUBDIVISION Absher Property BLOCK / SECTION _____ LOT 11 LOT AREA 1.78 acres SITE CLASS. PSI DESIGN FLOW 360 gpd L.T.A.R. .35

Septic Tank: 1000 Gallons; STB 782 Date 9-15-93
Pump Tank: _____ Gallons; PT _____ Date _____
Pump Make: _____ Model _____ Serial No. _____
Nitrification Field: No Fields 1 Square Feet 1050 Linear Feet 350
No Lines 5 Trench Width 36 Max Trench Bottom Depth 24 Gravel Depth 12

☒ New System ☐ Repair System Type: I, II, III, IV, V, VI
System Description: Conv Gravity
Repair System Description: " "
Maintenance Agreement Required: ☐ Yes ☒ No


☒ House/Mod. Home No. Bedrooms 3
☐ Mobile Home No. Bathrooms 2
☐ Business No. Employees ____
☐ Other _____
☐ Slab ☒ Crawl Space ☐ Basement w/plumbing ☐ Basement wo/plumbing

Water Supply:
☐ Individual
☐ Community
☒ Public


Comments:

Comments:

INITIAL SITE SKETCH

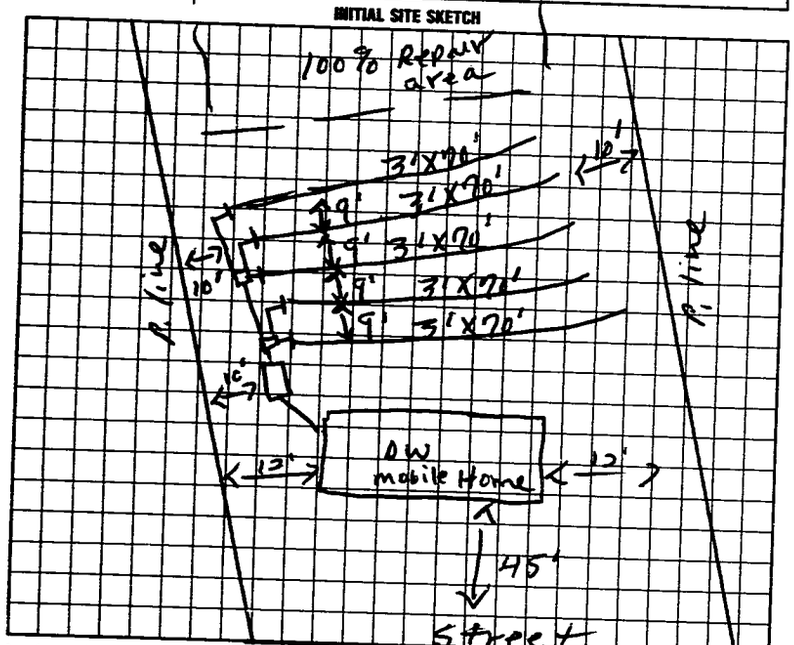


AS BUILT SKETCH

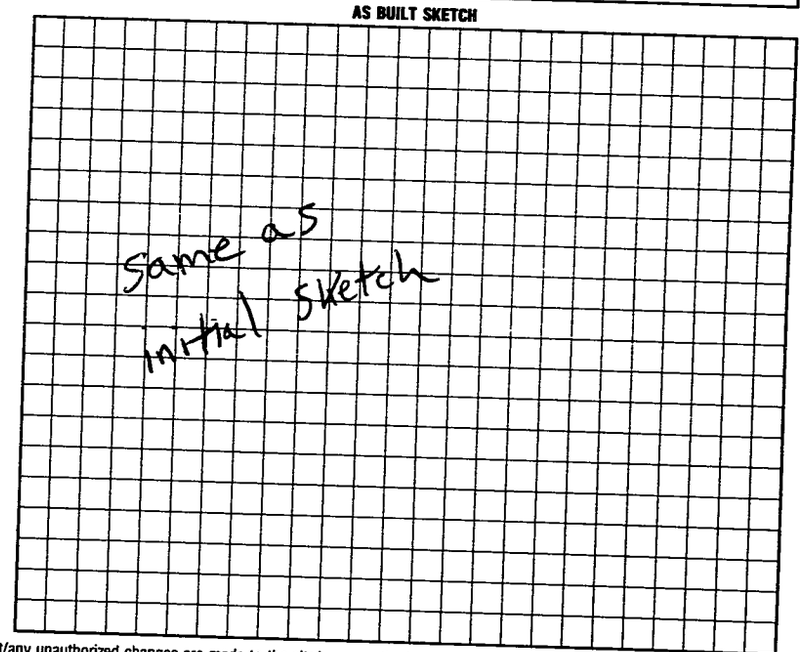


I understand that this permit can be suspended or revoked if any false information is supplied toward securing the permit/any unauthorized changes are made to the site/any unauthorized changes are made in the installation of the system. Improvement Permit is valid for 60 months from date of issuance.

Signed: x Derick Leroy Summers 10-14-93

Improvement Permit by: L. C. Moore date 10-14-93

Existing System Inspection by: _____ date _____

Installed by: A-1 Backhoe

Certificate of Completion by: L. C. Moore date 10-21-93

Operation Permit by: _____ date _____

HEALTH DEPT. COPY: WHITE INSPECTION COPY (FINAL): GREEN OWNER COPY (FINAL): YELLOW INSPECTION COPY (INITIAL): PINK OWNER COPY (INITIAL): GOLD