IREDELL COUNTY HEALTH DEPARTMENT

Statesville Phone TR 3-7271 Mooresville Phone NO 3-1271

PERMIT TO INSTALL SEPTIC TANK

Permit NO. _____ Permit Date June 16 1959

Owner Palmes & Asber - Cf Little Address Belmont RC

Installed By CLYDE HOKE Address _____


Location of Property On Right before end of pAvment #4

Tank		Capacity		Length of Lines		Fixtures	
Block	(✓)	800	(✓)	150'	(✓)	No. of Baths	( )
Precast	( )	900	( )	175'	( )	Dishwasher	( )
		1000	( )	200'	( )	Garbage Grdr.	( )
tANK by		1100	( )	225'	( )	Auto-Washer	( )
Cf Little		1200	( )	250'	( )	Other	
		Other		Other			

NOTIFY HEALTH DEPARTMENT AT LEAST EIGHT HOURS BEFORE TANK IS TO BE INSPECTED.

Final Inspection June 16 1959 Approved ( ) Disapproved ( )

Remarks Not for washer - Central WAter Supply Self App.

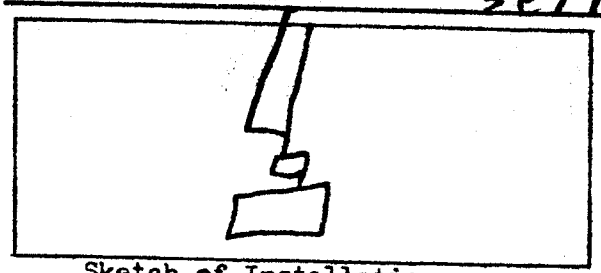

Sketch of Installation

Sanitarian