IREDELL COUNTY HEALTH DEPARTMENT

Statesville Phone TR 3-7271

Mooresville Phone NO 3-1271

Permit NO. _____

PERMIT TO INSTALL SEPTIC TANK

Permit Date June 16 1957

Owner Palmer & Asber Cf Little Address Belmont Rd

Installed By CLYDE HOKE Address _____

Location of Property on Right before end of pavement #5

Tank

Block ( )
Precast ( )


TANK by Cf Little

Capacity		Length of Lines		Fixtures	
800	( )	150'	( )	No. of Baths	( )
900	( )	175'	( )	Dishwasher	( )
1000	( )	200'	( )	Garbage Grdr.	( )
1100	( )	225'	( )	Auto-Washer	( )
1200	( )	250'	( )	Other	( )
Other _____		Other _____			

NOTIFY HEALTH DEPARTMENT AT LEAST EIGHT HOURS BEFORE TANK IS TO BE INSPECTED.

Final Inspection June 16 1957 Approved ( ) Disapproved ( )

Remarks #5 Not for Washer - Central Water Supply Self Apd

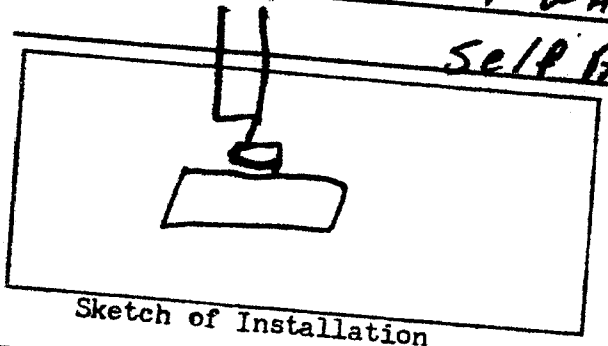

Sketch of Installation

Sanitarian