IREDELL COUNTY HEALTH DEPARTMENT

STATESVILLE 704-878-5305 MOORESVILLE 704-664-5281

IMPROVEMENT PERMIT / AUTHORIZATION TO CONSTRUCT / OPERATION PERMIT / EXISTING SYSTEM INSPECTION

PERMIT# 081927 PIN# 4754 54 7547 DATE 6-24-99

OWNER OR CONTRACTOR ERICKA DAWKINS PHONE: Business Home 871-8144

ADDRESS 540 STOCKTON STREET, STATESVILLE, NC 28677

LOCATION US 64 E, TR GREENBRIAR, TR ABSHER ROAD, 2ND LOT ON LFT BEFORE END

SUBDIVISION MURDOCK BLOCK / SECTION LOT 54 LOT AREA 0.45 ACRE SITE CLASS PS DESIGN FLOW 360 L.T.A.R. 0.30 GPD/FT²

Septic Tank: 1000 Gallons; STB 319 Date 9-8-99

Pump Tank: Gallons; PT Date

Pump Make: Model Serial No.

Nitrification Field: No Fields 1 Square Feet EQ TO 1200 Linear Feet 200

No Lines FIVE Trench Width 24" Max Trench Bottom Depth 36" Gravel Depth 6" SAND

☑ New System ☐ Repair System Type: I, II, (III), IV, V, VI

System Description: PPBPS, GRAVITY

Repair System Description: PPBPS, GRAVITY

Maintenance Agreement Required: ☐ Yes ☑ NO

☐ Slab ☑ Crawl Space ☐ Basement w/plumbing ☐ Basement wo/plumbing

☑ House/Mod. Home No. Bedrooms 3

☐ Mobile Home No. Bathrooms 2

☐ Business No. Employees


☐ Other

Water Supply: ☑ Individual ☐ Public ☐ Community WELL


Comments/Conditions: ① KEEP SYSTEM MINIMUM 100' FROM WELL ② INSTALL 50% REDUCTION SYSTEM USING FORTY-FIVE (45) PPBPS PANELS IN FIVE EQUAL LENGTH LINES ON CONTOUR

Comments/Conditions: SEPTIC TANK WITH MARKER INSTALLED USING "ZABEL" FILTER

INITIAL SITE SKETCH

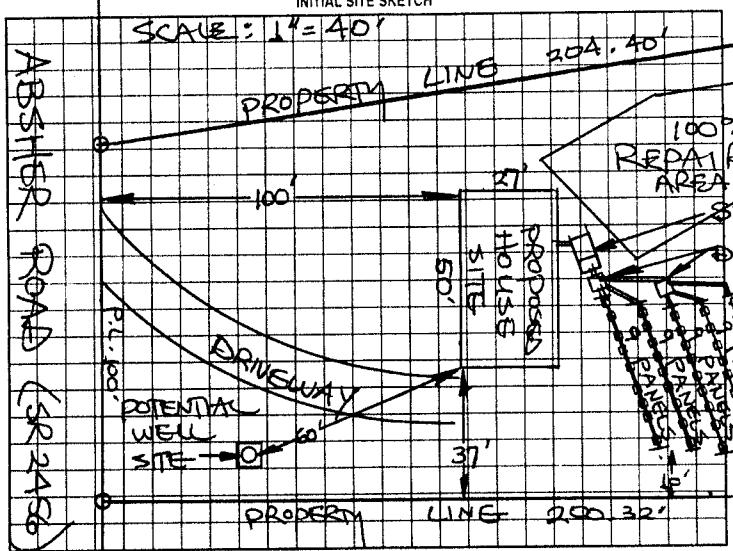

AS BUILT SKETCH

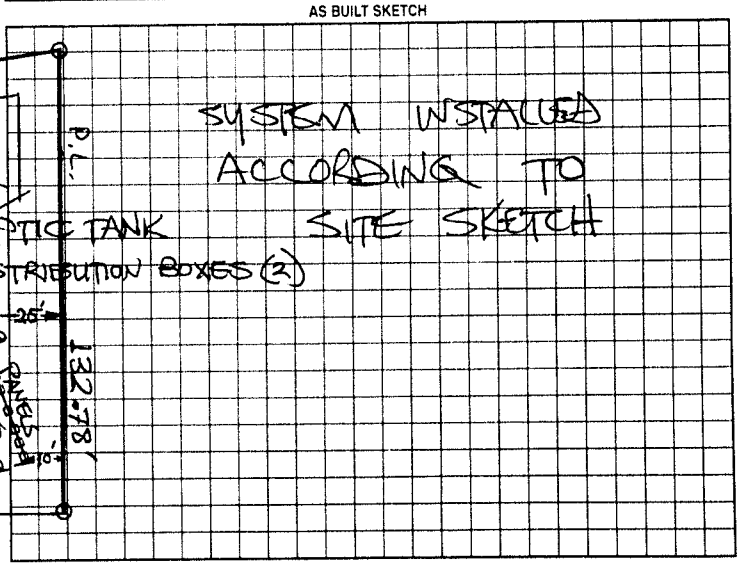

Permit can be suspended or revoked if any false information is supplied toward securing the permit/any unauthorized changes are made to the site/any unauthorized changes are made in the installation of the system. Improvement Permit with plat valid without expiration. Improvement Permit with site plan valid for sixty months. Authorization to Construct is valid for a period equal to that of Improvement Permit – not to exceed sixty months.

Signed: Ericka A. Dawkins date 6-25-99

Improvement Permit by: STEVE HEDRICK date 6-24-99

Authorization to Construct by: STEVE HEDRICK date 6-24-99

Installed by: DAVID UMBARGER

Operation Permit by: STEVE HEDRICK date 3-9-00

Existing System Inspection by: date

HEALTH DEPT COPY WHITE OWNER COPY (FINAL) YELLOW OWNER COPY (INITIAL) PINK