THIS PERMIT REPLACES PREVIOUSLY ISSUED PERMIT DATED 5-14-99.

IREDELL COUNTY HEALTH DEPARTMENT

STATESVILLE 704-878-5305 MOORESVILLE 704-664-5281

IMPROVEMENT PERMIT / AUTHORIZATION TO CONSTRUCT / OPERATION PERMIT / EXISTING SYSTEM INSPECTION

PERMIT# 08085011398 3 PIN# 4754-55-9904 DATE 4-30-03

OWNER OR CONTRACTOR Silverwing Properties PHONE: Business 704-763-4881 CELL Home

ADDRESS 5551 MONROE RD CHARLOTTE, NC 28212

LOCATION 64 EAST @ GREENSBORO, THRU CAUTION LIGHT, CROSS CREEK

SUBDIVISION 4 CREEK CROSSING BLOCK / SECTION LOT 9 LOT AREA 3.46 AC SITE CLASS. PS DESIGN FLOW 480 L.T.A.R. .3

Septic Tank: 1000 Gallons; STB 794 Date 5-8-03

Pump Tank: Gallons; PT Date

Pump Make: Model Serial No.

Nitrification Field: No Fields 1 Square Feet EA 1600 Linear Feet 400'

No Lines 3 x 133' Trench Width 36" Max Trench Bottom Depth 36" Gravel Depth N/A

☒ New System ☐ Repair System Type: I, II, (III) IV, V, VI

System Description: CPAN 2546 REDRAW

Repair System Description: SAME

Maintenance Agreement Required: ☐ Yes ☒ No

☐ House/Mod. Home ☒ Mobile Home ☐ Business ☐ Other

No. Bedrooms 4 No. Bathrooms 2 No. Employees

☐ Slab ☒ Crawl Space ☐ Basement w/plumbing ☐ Basement wo/plumbing


Water Supply: ☐ Individual ☒ Public ☐ Community

Comments:/Conditions: (1) SYSTEM ~~DESIGNED~~ DESIGNED IN SAME PLACE AS PREVIOUSLY DESIGNED. THIS IS A LIMITED REDRAW (2) YOU MUST MEET PRIOR TO ANY EXCAVATION FOR CONSULTATIVE VISIT. CALL 401


Comments:/Conditions: 704-928-2030 BETWEEN 8-9 AM. (3) INSTALL LINES ON CONTOURS & MAINTAIN SETBACKS. THIS INCLUDES POSITIVE DRAINAGE SETBACKS, CABEL FILTER & MARKER

"NOT TO SCALE"

INITIAL SITE SKETCH

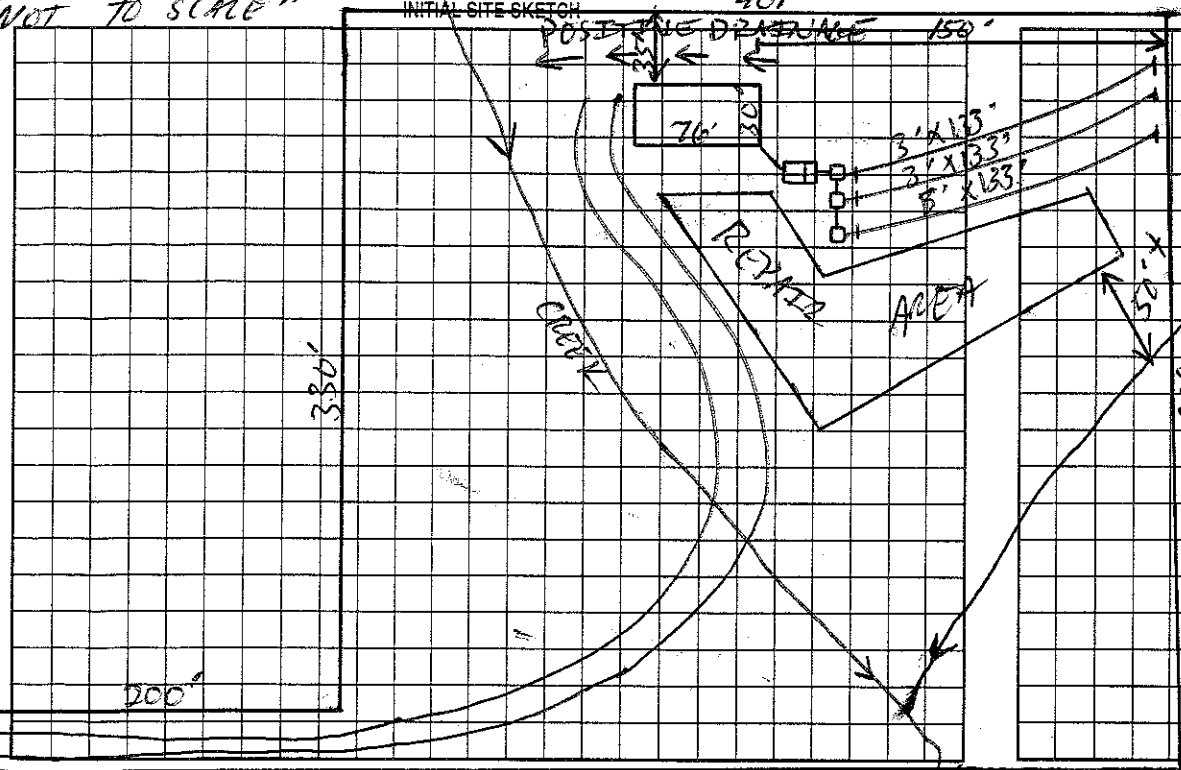

AS BUILT SKETCH INSTALLED AS SHOWN

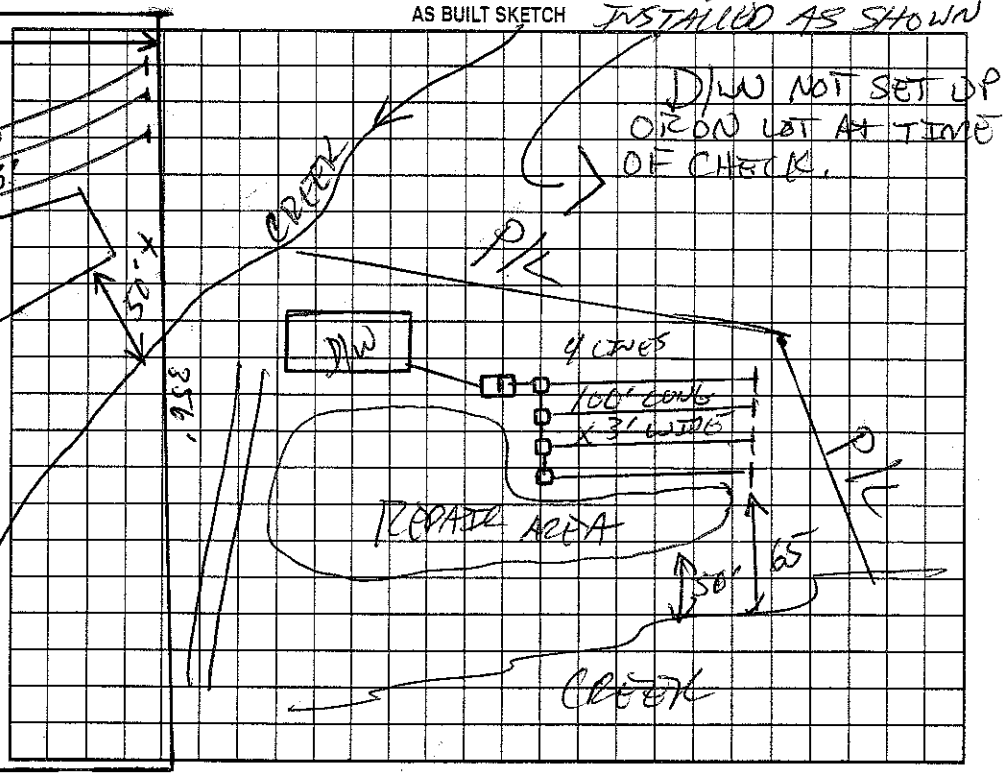

BOTTOM OF HILL FROM ROAD

Permit can be suspended or revoked if any false information is supplied toward securing the permit/any unauthorized changes are made to the site/any unauthorized changes are made in the installation of the system. Improvement Permit with plat valid without expiration. Improvement Permit with site plan valid for sixty months. Authorization to Construct is valid for a period equal to that of Improvement Permit – not to exceed sixty months.

Signed: date 5-6-03 Installed by: DELLINGER SEPTIC

Improvement Permit by: date 5-5-03 Operation Permit by: date 6-24-03

Authorization to Construct by: date 5-5-03 Existing System Inspection by: date

HEALTH DEPT. COPY: WHITE OWNER COPY (FINAL): YELLOW OWNER COPY (INITIAL): PINK