IREDELL COUNTY HEALTH DEPARTMENT

Statesville Phone TR 3-7271 — Mooresville Phone NO 3-1271

PERMIT TO INSTALL SEPTIC TANK

Permit No. 181 — Permit Date 10-3 1972

Owner Bldr. Johnson Bros. INC — Address STATESVILLE, NC

Installed By HARLEE LACKEY — Address STONY POINT, N.C


Location of Property EAST Blood St. Ext. 1st House on Right After Crossing Creek. Across From EAST IREDELL ELEM. School ENTRANCE.

Tank		Capacity		Length of Lines		Fixtures	
Block	( )	1000	(✓)	225'	( )	No. of Baths	(2½
Precast	(✓)	1250	( )	250'	( )	Dishwasher	( )
		1500	( )	Other 240		Garbage Grdr.	( )
		Other				Other	

NOTIFY HEALTH DEPARTMENT AT LEAST EIGHT HOURS BEFORE TANK IS TO BE INSPECTED.

Final Inspection 10-3 1972 — Approved (✓) Disapproved ( )

Remarks IREDELL WATER CORP.

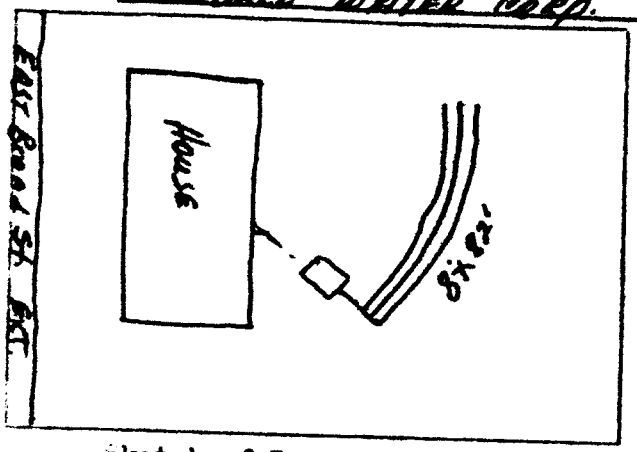

Sketch of Installation

Sanitarian