IREDELL COUNTY HEALTH DEPARTMENT

Statesville Phone TR 3-7271 Mooresville Phone NO 3-1271

PERMIT TO INSTALL SEPTIC TANK

Permit No. 181 Permit Date 10-3 1972

Bldr. Johnson Bros. Inc

Owner _____ Address Statesville, NC

Installed By HARLEE LACKEY Address Stony Point, NC


Location of Property EAST Broad St. Ext. 2nd House ON Rt AFTER CROSSING CREEK - Across From East IREDELL ELEM. School ENTRANCE -

Tank		Capacity		Length of Lines		Fixtures	
Block	( )	1000	(✓)	225'	( )	No. of Baths	(2)
Precast	(✓)	1250	( )	250'	( )	Dishwasher	( )
		1500	( )	Other 230		Garbage Grdr.	( )
		Other _____				Other _____	

NOTIFY HEALTH DEPARTMENT AT LEAST EIGHT HOURS BEFORE TANK IS TO BE INSPECTED.

Final Inspection _____ 19___ Approved (✓) Disapproved ( )

Remarks IREDELL WATER CORP.

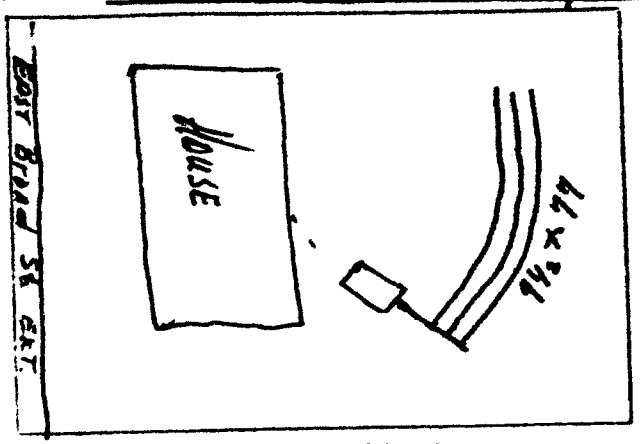

Sketch of Installation

LAUNDRY IN BASEMENT [redacted]

Sanitarian