IREDELL COUNTY HEALTH DEPARTMENT - *ENVIRONMENTAL HEALTH* ☐ STATESVILLE OFFICE 704-878-5305 ☐ MOORESVILLE OFFICE 704-664-5281

IMPROVEMENT PERMIT / AUTHORIZATION TO CONSTRUCT / OPERATION PERMIT / EXISTING SYSTEM INSPECTION

PERMIT # REPAIR PIN # 4754-64-2724 DATE MAY-7 2012

OWNER GEORGIA ANN TURNER APPLICANT: SAME PHONE: Home/Cell # 704-968-4894 Business # 704-873-1729

SITE ADDRESS 600 S. GREENBRIAR ROAD OWNER / APPLICANT ADDRESS SAME

SITE DIRECTIONS US 64 EAST, TR GREENBRIAR ROAD, CROSS E. BROAD ST, #600 ON RIGHT

SUBDIVISION NA BLOCK / SECTION NA LOT # NA LOT AREA 0.6 ACRE DESIGN FLOW 360 L.T.A.R. 0.5 GPD/FT2

Septic Tank EXISTING Gallons: STB ____ Date ____

Pump Tank ____ Gallons: P T ____ Date ____

Pump Make ____ Model ____ Serial # ____

No. Nitrification Fields: 1 No. Lines 4 Linear Feet 200

Trench Width 36" Max. Trench Bottom Depth 36"

☐ New System ☑ Repair ☐ Expansion System Type I II III IV V VI

System Description: ____

Repair System Description: 25% REDUCTION, GRAVITY

Maintenance Agreement Required ☐ YES ☑ NO

Gravel Depth N/A ☑ GRAVITY ☐ PRESSURE

☑ Residence No. Bedrooms 3

☐ Business No. Persons ____

☐ Other No. Employees ____


☐ Slab ☐ Crawl Space

☐ Basement w/plumbing ☑ Basement w/o plumbing

Water Supply: ☐ Private ☑ Public ☐ Community

Comments / Conditions INSTALL 25% REDUCTION SYSTEM ON CONTOUR AS FLAGGED ON SITE USING 25% REDUCTION SYSTEM. ABANDON EXISTING DRAINFIELD (GRAVEL BED).

INITIAL SITE SKETCH

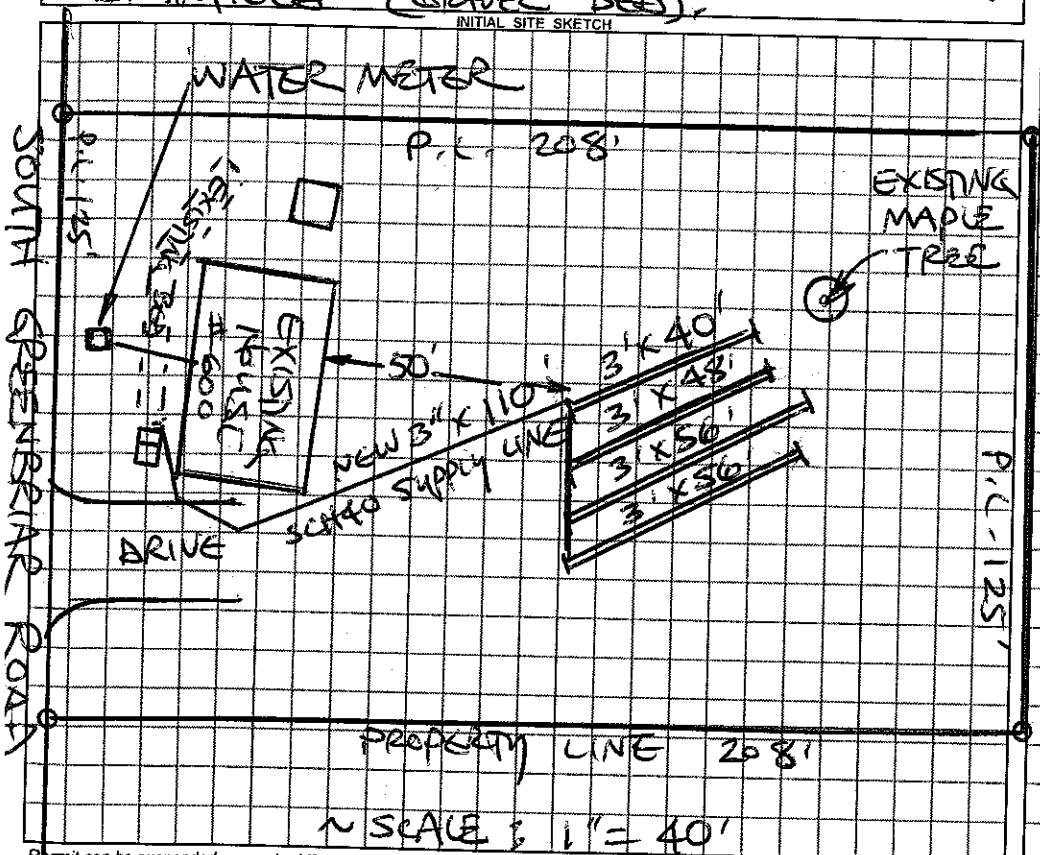

AS BUILT SKETCH

SYSTEM REPAIRED ACCORDING TO INITIAL SITE SKETCH

Permit can be suspended or revoked if any false information is supplied toward securing the permit / any unauthorized changes are made to the site / any unauthorized changes are made in the installation of the system.

☐ ***IMPROVEMENT PERMIT*** *with plat valid without expiration.* ☑ ***IMPROVEMENT PERMIT*** *with plat valid without expiration.* ☑ ***AUTHORIZATION TO CONSTRUCT*** valid for period equal to IMPROVEMENT PERMIT--not to exceed 60 mo.

Site Plan Valid

Owner / Applicant Signature: Josie Matthews Date 5-8-12 Installed by: A-1 BACKHOE

IMPROVEMENT PERMIT by: STEVE HENDRICK REHS Date 5-7-2012 OPERATION PERMIT by: STEVE HENDRICK REHS Date 6-26-12

AUTHORIZATION TO CONSTRUCT by: STEVE HENDRICK REHS Date 5-7-2012 Existing System Inspected by: ____ REHS Date ____

YOU SHOULD CONTACT A LOCATOR SERVICE PRIOR TO ANY EXCAVATION

White Copy – Environmental Health YELLOW COPY (Final) Owner / Applicant PINK COPY (Initial) Owner / Applicant