HIGHER LEARNING PRESCHOOL, INC

IREDELL COUNTY HEALTH DEPARTMENT

STATESVILLE 704-878-5305 MOORESVILLE 704-664-5281 (C)

IMPROVEMENT PERMIT / AUTHORIZATION TO CONSTRUCT / OPERATION PERMIT / EXISTING SYSTEM INSPECTION

PERMIT# 145050 PIN# 4754-64-4546 DATE 9-18-2007

OWNER OR APPLICANT LAMONICA DALTON PHONE: Business 704-657-6962 Home

ADDRESS 607 S. GREENBRIAR ROAD, STATESVILLE NC 28625

LOCATION US 64 EAST, TR S. GREENBRIAR ROAD, DAY CARE ON LEFT AT BOX # 607

SUBDIVISION BLOCK / SECTION LOT LOT AREA 0.146 ACRE SITE CLASS. PS DESIGN FLOW 360 L.T.A.R. EXISTING

Septic Tank: 1000 Gallons; STB Date
Pump Tank: Gallons; PT Date
Pump Make: Model Serial No.
Nitrification Field: No Fields 1 Square Feet Linear Feet EXISTING
No Lines 1 BED / 2 LINES Trench Width Max Trench Bottom Depth Gravel Depth

☐ New System ☐ Repair ☐ Expansion System Type: I (II) III IV V VI
System Description: CONVENTIONAL, GRAVITY
Repair System Description:
Maintenance Agreement Required: ☐ Yes ☒ No

☐ House/Mod. Home No. Bedrooms
☐ Mobile Home No. Persons 24
☒ Business No. Employees
☐ Other DAYCARE W/24 MAX


Water Supply: ☐ Individual ☒ Public ☐ Community

☒ Gravity ☐ Pressure ☐ Slab ☒ Crawl Space ☐ Basement w/plumbing ☐ Basement wo/plumbing


Comments:/Conditions:

Comments:/Conditions: (1) SYSTEM UNDERSIZED ACCORDING TO TODAY'S STANDARDS
(2) SYSTEM APPROVED FOR 24 PERSONS MAXIMUM (CHILDREN & STAFF)

INITIAL SITE SKETCH

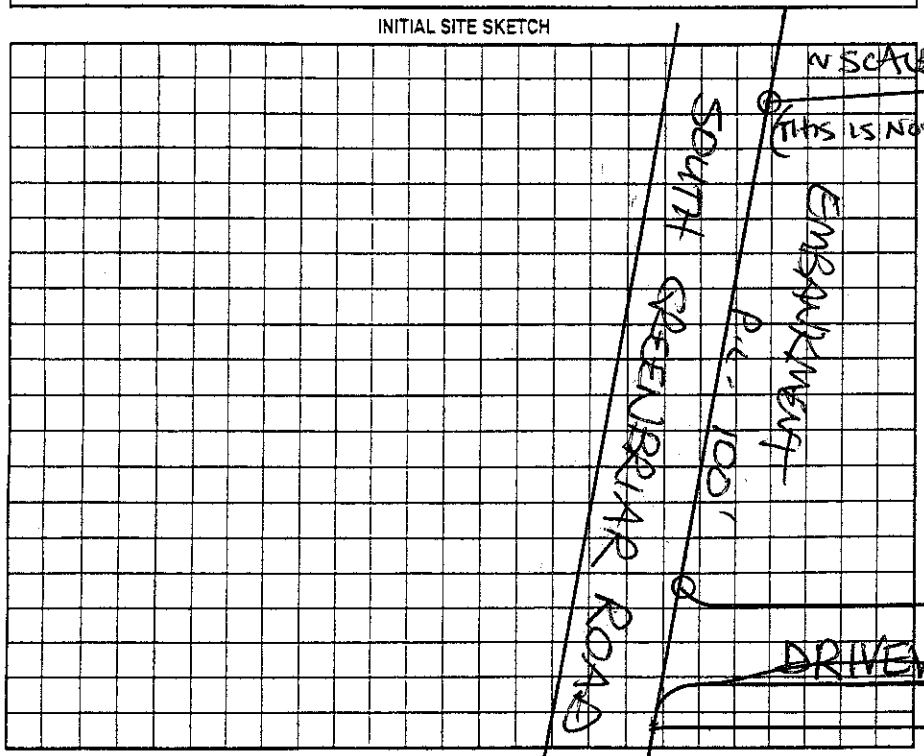

AS BUILT SKETCH

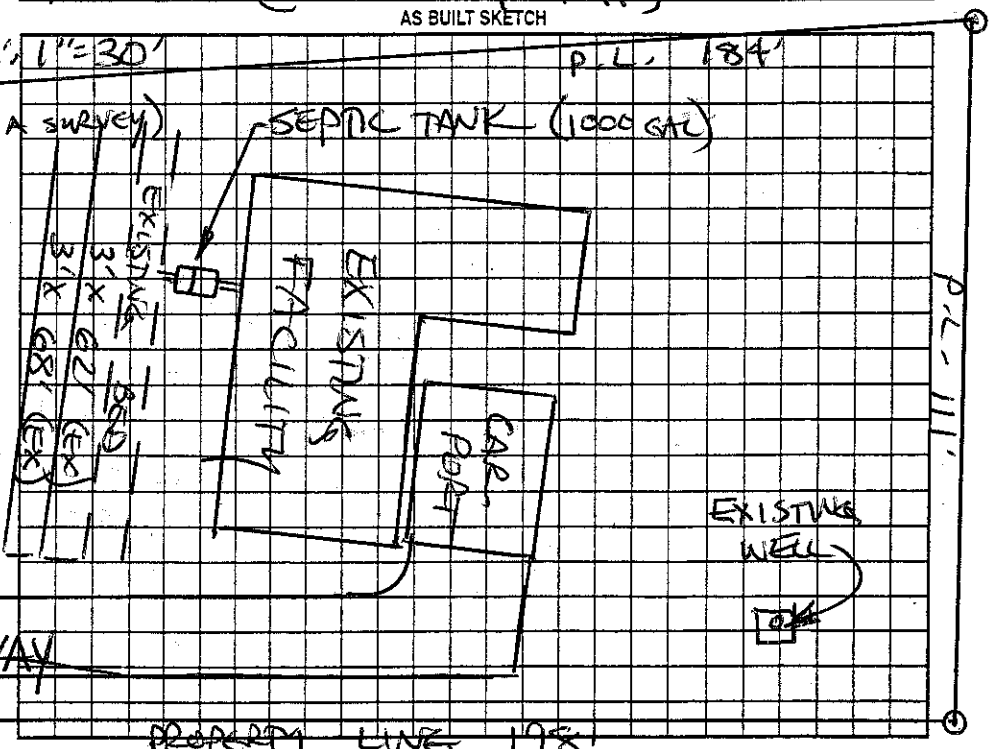

Permit can be suspended or revoked if any false information is supplied toward securing the permit/any unauthorized changes are made to the site/any unauthorized changes are made in the installation of the system. Improvement Permit with plat valid without expiration ☐ Improvement Permit with site plan valid for sixty months ☐ Authorization to Construct is valid for a period equal to that of Improvement Permit – not to exceed sixty months.

Signed: date Installed by:

Improvement Permit by: date Operation Permit by: date

Authorization to Construct by: date Existing System Inspection by: STEVE HEDRICK date 9-18-2007

HEALTH DEPT. COPY: WHITE OWNER COPY (FINAL): YELLOW OWNER COPY (INITIAL): PINK