IREDELL COUNTY HEALTH DEPARTMENT

STATESVILLE 704-878-5305 (or) MOORESVILLE 704-664-5281

IMPROVEMENT PERMIT / AUTHORIZATION TO CONSTRUCT / OPERATION PERMIT / EXISTING SYSTEM INSPECTION

PERMIT # 1106109 PIN # 4754 65 2555 DATE

OWNER or APPLICANT Wade & Winesta Morrison PHONE: Business Home: 704-799-1881

OWNER or APPLICANT ADDRESS 560 S Greenbriar Rd Statesville NC 28625

LOCATION / DIRECTIONS 64E (R) Greenbriar to 560 S Greenbriar on right Red house

SUBDIVISION BLOCK / SECTION LOT # 7.65 LOT AREA DESIGN FLOW 0151 L.T.A.R. 0151A

Septic Tank 0151 Gallons: STB Date

Pump Tank Gallons: P T Date

Pump Make Model Serial #

Nitrification Field No Fields 1 No Lines 0151 Linear Feet 0151

Trench Width 0151A Max. Trench Bottom Depth 0151 Gravel Depth 0151

☑ New System ☐ Repair ☐ Expansion System Type I II III IV V VI

System Description: Conventional Ground

Repair System Description:

Maintenance Agreement Required ☐ YES ☑ NO

☑ GRAVITY ☐ PRESSURE

☑ Residence No. Bedrooms 0151

☐ Business No. Persons

☐ Other No. Employees

☐ Slab ☐ Crawl Space

☑ Basement w/plumbing ☐ Basement w/o plumbing

Water Supply: ☐ Private ☑ Public ☐ Community

Comments / Conditions


New 10/18 Sun Room does not interfere with Septic.

Maintain all setbacks.

INITIAL SITE SKETCH

Comments / Conditions

AS BUILT SKETCH

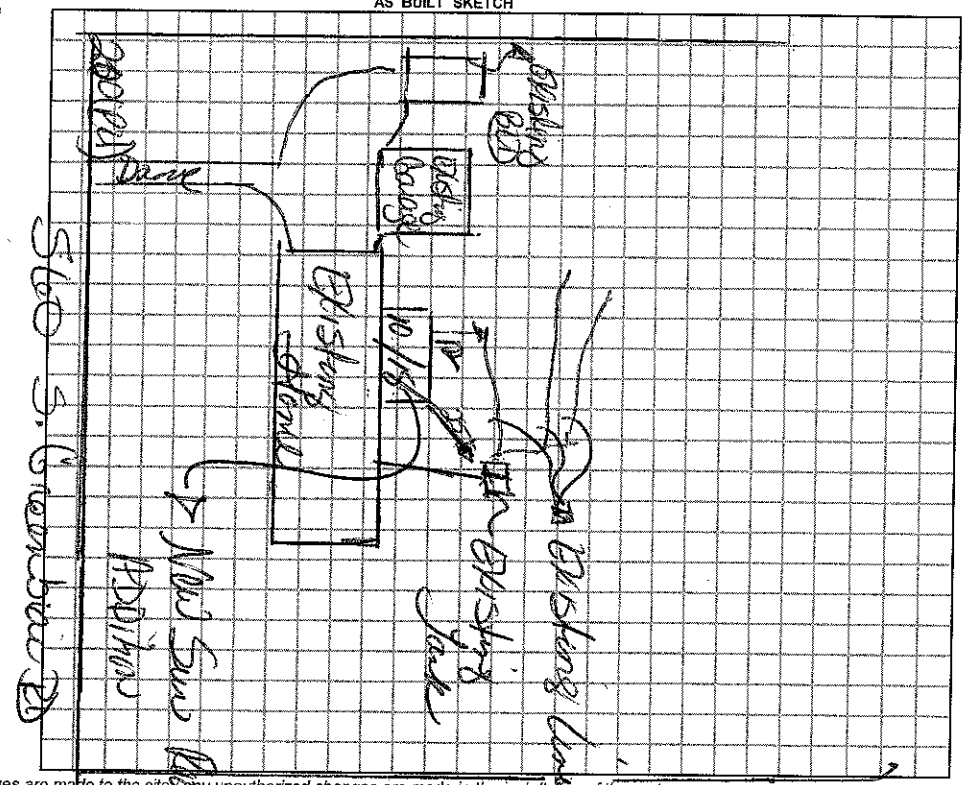

Permit can be suspended or revoked if any false information is supplied toward securing the permit / any unauthorized changes are made to the site / any unauthorized changes are made in the installation of the system.

☐ *IMPROVEMENT PERMIT w / plat valid without expiration.* ☐ *IMPROVEMENT PERMIT w / site plan valid for 60 mos.* ☑ *AUTHORIZATION TO CONSTRUCT valid for period equal to IMPROVEMENT PERMIT-not to exceed 60 mo.*

Owner / Applicant Signature: Date

Improvement Permit by: Date

Authorzation to Construct by: Date

YOU SHOULD CONTACT A LOCATOR SERVICE PRIOR TO ANY EXCAVATION.

Installed by:

Operation Permit by: Date:

Existing System Inspected by: Date: 3-9-10

WHITE COPY Environmental Health YELLOW COPY (Final) Owner / Applicant PINK COPY (Initial) Owner / Applicant