IREDELL COUNTY HEALTH DEPARTMENT

Statesville Phone TR 3-7271 Mooresville Phone NO 3-1271

PERMIT TO INSTALL SEPTIC TANK

Permit NO. _____ Permit Date April 23 1969

Owner Lawn & Country Real Co. Address Mitchell #4, Statesville

Installed By Hake Lite Tank Co Address Statesville

Location of Property S/S of East Broad St ext.


Mitchell College prop.

Tank		Capacity		Length of Lines		Fixtures	
Block	( )	800	( )	150'	( )	No. of Baths	(2)
Precast	(✓)	900	( )	175'	( )	Dishwasher	(✓)
		1000	( )	200'	( )	Garbage Grdr.	(✓)
		1100	( )	225'	( )	Auto-Washer	(✓)
		1250	(✓)	250'	(✓)	Other	_____
		Other	_____	Other	_____		

NOTIFY HEALTH DEPARTMENT AT LEAST EIGHT HOURS BEFORE TANK IS TO BE INSPECTED.

Final Inspection April 23 1969 Approved (✓) Disapproved ( )

Remarks _____

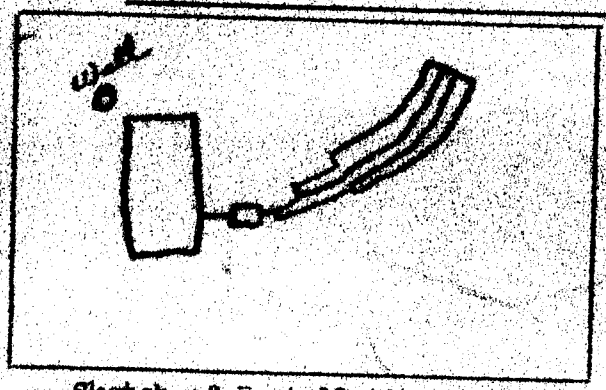

Sketch of Installation

Sanitarian