IREDELL COUNTY HEALTH DEPARTMENT

Statesville Phone TR 3-7271 Mooresville Phone No. 664-5281

PERMIT TO INSTALL SEPTIC TANK

Permit No. 36 Permit Date 10-31 1972

Owner Twin Oaks Golf Club Address Statesville NC

Installed By H. H. Sigmon Jr. Address Statesville, NC
Sigmon Septic Tank Service

Location of Property


Off Murdock Rd.

Tank		Capacity		Length of Lines		Fixtures	
Block	( )	1000	( )	225'	( )	No. of Baths	( )
Precast	( )	1250	( )	250'	( )	Dishwasher	( )
		1500	( )	Other 130'		Garbage Grdr.	( )
		Other				Other	

NOTIFY HEALTH DEPARTMENT AT LEAST EIGHT HOURS BEFORE TANK IS TO BE INSPECTED.

Final Inspection 19 Approved (✓) Disapprcved ( )

Remarks

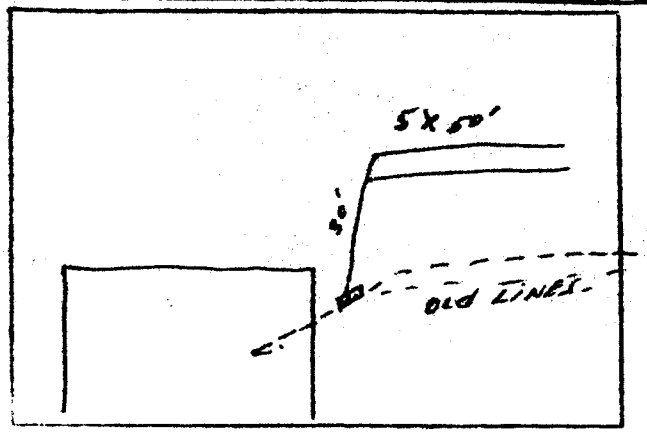

Sketch of Installation

Sanitarian